

FEB 03 1999

BARRY COUNTY REMONUMENTATION

LAND CORNER RECORDATION CERTIFICATE
Filing Requirement of Act 74, Mich. P.A. 1970

SECTION

For Corners in BARRY
(county)

Located In:

Corner Code #



2687
Page: 1 of 1
10/26/1998 10:57R

1. Public Land Survey T 2N R 9W L-6
CENTER OF SECTION 13 T _____ R _____
HOPE TOWNSHIP T _____ R _____
T _____ R _____

2. Property Controlling S _____ T _____ R _____
in Section S _____ T _____ R _____

3. Miscellaneous S _____ T _____ R _____
Property in Sec. S _____ T _____ R _____

4. Lot No. _____ Recorded Plat _____

5. Private Claims _____

Register of Deeds Stamp & File Number

I, **Brian Reynolds**, in a field survey on **9 OCTOBER, 1998** do hereby certify that under requirements of P.A. 74, Michigan P.A. of 1970, the corner points mentioned in lines 1 and 2 above were in conformance with regulations and rules therefore as required in the current manual of survey instructions of the United States Department of the Interior, Bureau of Land Management or by a decree of a Court of Law and/or that the corner points mentioned in lines 3, 4, and 5 above were in conformance with the rules of the Michigan Board of Land Surveyors or by a Decree of a Court of Law, established, re-established, monumented, re-monumented, recovered, found as expressed below.

NOTE: Not more than 2 corners, all in the same town and range, may be recorded on this certificate.

	A	B	C	D	E	F	G	H	I	J	K	L	M
2	6	5	4	3	2	1							
3													
4	7	8	9	10	11	12							
5													
6	18	17	16	15	14	13							
7													
8	19	20	21	22	23	24							
9													
10	30	29	28	27	26	25							
11													
12	31	32	33	34	35	36							
13													

A. Description of original monument and accessories and/or subsequent restoration:

1. THIS CORNER WAS NOT SET BY THE GENERAL LAND OFFICE.
2. COUNTY SURVEYOR RECORDS: WALTER HEATH, 1903 (TAN HOPE FIELD BOOK, P.10)
"SET 3/4" IRON PIPE @ INT. 1/4 LINES" WHITE OAK 9 S23°20'W 1.68

*** NO OTHER RECORDED HISTORICAL INFORMATION AVAILABLE FOR THIS CORNER ***

B. Description of corner evidence found and/or method applied in restoring or reestablishing corner:


FOUND 3/4" PIPE AND WHITE OAK WITNESS (MUCH LARGER NOW) BY HEATH. DISTANCES TO FOUND PIPE BY HEATH AT 1/8 CORNER 1/4 MILE WEST AND THE WEST 1/4 CORNER (K-6) AS RECORDED BY PAUL VANKOOTEN IN L.C.R.C.#227 COMPARE FAVORABLY.

ACCEPTED FOUND 3/4" PIPE BY HEATH AS PERPETUATION OF A PROPER ESTABLISHMENT OF THE CORNER POSITION.

PLACED STANDARD BARRY COUNTY REMONUMENTATION ALUMINUM CAP ON FOUND PIPE.

C. Description of monument for corner and accessories established to perpetuate locating the position of the corner:

SET STANDARD BARRY COUNTY REMONUMENTATION ALUMINUM CAP ON FOUND PIPE.
SET 20d NAIL W/REMON TAG IN THE NORTH SIDE OF A 15" MAPLE N70°W 29.52'
SET 20d NAIL W/REMON TAG IN THE EAST SIDE OF A 20" OAK N20°E 43.93'
SET 20d NAIL W/REMON TAG IN THE NORTHWEST SIDE OF A 15" OAK S45°W 39.73'
SET 20d NAIL W/REMON TAG IN THE NORTH SIDE OF A 30" HICKORY N85°E 11.88'
ON NORTHEAST EDGE OF TRAIL AT BEND (BENDING FROM EAST-WEST TO NORTH)
CORNER LIES 520'+/- WEST OF CENTERLINE OF GURD ROAD (DOWN DRIVE TO HOUSE #6500)
IN LINE WITH FENCE EAST

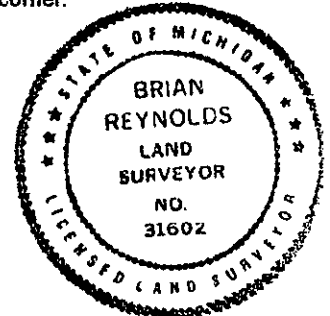

Signed by [Signature]
Surveyor's Michigan License No 31602

Date 10/19/1998

FORM APPROVED BY MICHIGAN STATE BOARD OF LAND SURVEYORS. JAN. 28, 1971
REVISED MAY 14, 1975 REVISED JANUARY, 1983 REVISED OCTOBER 1995

ACT 345 BARRY COUNTY REMONUMENTATION
APPROVED BY PEER REVIEW AT A MEETING HELD ON
8 July 96 BR
BRIAN REYNOLDS COUNTY SURVEYOR