STATE OF MICHIGAN
COUNTY OF BARRY
RECEIVED FOR RECORD

DEC 14 8 54 AM '93

Sandy Schondelmayer
REGISTER OF DEEDS

002166

Register of Deeds Stamp & File Number

CENTER OF SECTION 24 HOPE TOWNSHIP

BARRY COUNTY REMONUMENTATION

LAND CORNER RECORDATION CERTIFICATE

Filing Requirement of Act 74, Mich. P.A. 1970

or corners in BARRY (County)

	Located In:	Corner Code #
Public Land Survey	T ___ R ___	
	T ___ R ___	
	T ___ R ___	
	T ___ R ___	
Property Controlling	S 24 T 2N R 9W	L-8
in Section	S ___ T ___ R ___	HOPE TWP.
Miscellaneous	S ___ T ___ R ___	
Property in Sec.	S ___ T ___ R ___	

Lot No. _____, Recorded Plat _____

Private Claims _____

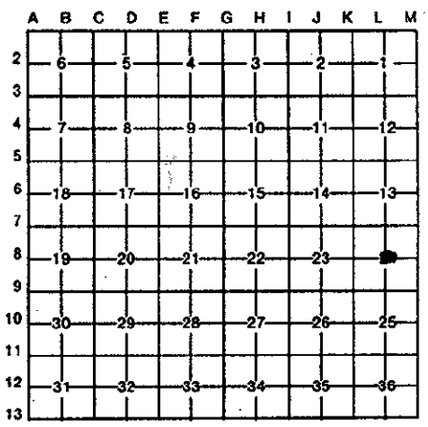

BRIAN REYNOLDS, in a field survey on NOVEMBER 9TH, 19 93, I hereby certify that under requirements of P.A. 74, Michigan P.A. of 1970, the corner points mentioned lines 1 and 2 above were in conformance with regulations and rules therefore as required in the current manual of survey instructions of the United States Department of the Interior, Bureau of Land Management or by a decree of a Court of Law and/or that the corner points mentioned in lines 3, 4 and 5 above were in conformance with the rules of the Michigan Board of Land Surveyors or by a Decree of a Court of Law; established, re-established, monumented, re-monumented, recovered, found as expressed below:

NOTE: Not more than 4 corners, all in the same town and range, may be recorded on this certificate.

Description of original monument and accessories and/or subsequent restoration:

NOT SET BY GLO SURVEY
SURVEY NOTES BY SETH PRATT, CO. SURVEYOR DONE APRIL 18-19, 1883 INDICATES BY DIMENSIONS THAT CENTER OF SECTION 15 MIDWAY BETWEEN EAST AND WEST 1/4 CORNERS.
NO WITNESSES GIVEN AND TYPE OF MONUMENT SET NOT INDICATED.

Description of corner evidence found and/or method applied in restoring or reestablishing corner:

FOUND NO EVIDENCE OF PRATT'S CORNER AND FOUND NO OTHER CORNER AT TRUE LOCATION.
SET STANDARD BARRY CO. MONUMENT W/CAP AT INTERSECTION OF 1/4 LINES.

SURVEY & REMONUMENTATION
APR 0 5 1994
COMMISSION

Description of monument for corner and accessories established to perpetuate locating the position of the corner:

3/4" BARRY CO. REMON. IRON W/CAP
NAIL & TAG IN NORTHWEST SIDE 8" RED OAK N40°E 25.97'
NAIL & TAG IN WEST SIDE 12" SASSAFRAS N30°E 57.38'
NAIL & TAG IN NORTHEAST SIDE 14" RED OAK N50°W 18.19'
NAIL & TAG IN NORTHEAST SIDE 10" SASSAGRAS N40°W 52.27'
ON LINE WITH OLD FENCE TO WEST
IN CENTERLINE OF NORTH-SOUTH GRAVEL ROAD

STATE OF MICHIGAN
BRIAN REYNOLDS
LAND SURVEYOR
NO. 31602
LICENSED LAND SURVEYOR

Signed by Brian Reynolds Date DECEMBER 7, 1993

Surveyor's Michigan License No. 31602

FORM APPROVED BY MICHIGAN STATE BOARD OF LAND SURVEYORS, JAN. 28, 1971
REVISED MAY 14, 1975
REVISED JAN., 1983