

BARRY COUNTY REMONUMENTATION

LAND CORNER RECORDATION CERTIFICATE  
Filing Requirement of Act 74, Mich. P.A. 1970

STATE OF MICHIGAN  
COUNTY OF BARRY  
RECEIVED FOR RECORD

DEC 14 8 54 AM '93

Sandy Schondelmaier  
REGISTER OF DEEDS

002172

Register of Deeds Stamp & File Number

corners in  
BARRY  
(County)

Located In: Corner Code #

T <u>2N</u> R <u>9W</u>	<u>M-8</u>
T _____ R _____	<u>HOPE</u>
T _____ R _____	_____
T _____ R _____	_____
T _____ R _____	_____
S _____ T _____ R _____	_____
S _____ T _____ R _____	_____
S _____ T _____ R _____	_____
S _____ T _____ R _____	_____

Public Land Survey

Property Controlling  
in Section

Miscellaneous  
Property in Sec.

Lot No. \_\_\_\_\_, Recorded Plat \_\_\_\_\_

Private Claims \_\_\_\_\_

	A	B	C	D	E	F	G	H	I	J	K	L	M
2	6		5		4		3		2		1		
3													
4	7		8		9		10		11		12		
5													
6	18		17		16		15		14		13		
7													
8	19		20		21		22		23		24		
9													
10	30		29		28		27		26		25		
11													
12	31		32		33		34		35		36		
13													

BRIAN REYNOLDS in a field survey on NOVEMBER 9TH, 19 93  
I hereby certify that under requirements of P.A. 74, Michigan P.A. of 1970, the corner points mentioned  
lines 1 and 2 above were in conformance with regulations and rules therefore as required in the  
current manual of survey instructions of the United States Department of the Interior, Bureau of Land  
Management or by a decree of a Court of Law and/or that the corner points mentioned in lines 3, 4 and 5  
above were in conformance with the rules of the Michigan Board of Land Surveyors or by a Decree of a  
Court of Law; established, re-established, monumented, re-monumented, recovered, found as  
expressed below:

NOTE: Not more than 4 corners, all in the same town and range, may be recorded  
on this certificate.

Description of original monument and accessories and/or subsequent restoration:

CORNER ESTABLISHED BY G.L.O. DEPUTY SURVEYOR JOHN MULLETT UNDER CONTRACT DATED  
JANUARY 5, 1826. SET POST 1/4 SECTION CORNER  
BEECH 10 S31W 43  
W. OAK 16 N38 1/2W 25

Description of corner evidence found and/or method applied in restoring or reestablishing corner:

FOUND NO EVIDENCE OF ORIGINAL CORNER. PROJECTED EAST AND WEST 1/4 LINE FROM  
WEST 1/4 POST EAST THROUGH OCCUPATION AT CENTER AND NORTH 1/8 POST OF SOUTHEAST  
1/4 TO INTERSECT RANGE LINE. HOLD NORTHEAST CORNER AS ESTABLISHED AND NORTH-SOUTH  
FENCE LINE NEAR 1/4 CORNER TO ESTABLISH RANGE LINE. SET 3/4" REMONUMENTATION  
IRON AND CAP AT INTERSECT POINT.


SURVEY &  
REMONUMENTATION

APR 05 1994

COMMISSION

Description of monument for corner and accessories established to perpetuate locating the position of the corner:

3/4" REMONUMENTATION IRON AND ALUM. CAP  
40D NAIL & WITNESS TAG IN NORTH FACE 12" POPLAR S47°W 15.58'  
40D NAIL & WITNESS TAG IN WEST FACE 14" BEECH S9°W 32.21'  
40D NAIL & WITNESS TAG IN SOUTH FACE 14" POPLAR S85°W 9.13'  
40D NAIL & WITNESS TAG IN NORTH FACE 20" OAK N59°E 39.37'  
40D NAIL & WITNESS TAG IN SOUTHEAST FACE 24" OAK N31°E 42.04'  
IN NORTH AND SOUTH FENCE  
FENCE CORNER POST W/FE TO EAST IS-SOUTH 6.1'

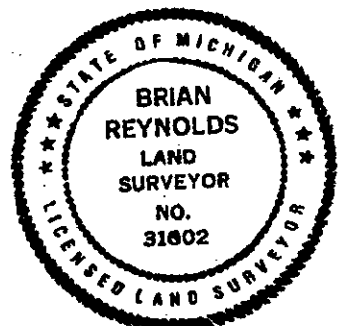

Signed by [Signature]  
Surveyor's Michigan License No. 31602

Date DECEMBER 7, 1993