

SURVEY & REMONUMENTATION

AUG 31 1994

**BARRY COUNTY REMONUMENTATION
LAND CORNER RECORDATION CERTIFICATE**
Filing Requirement of Act 74, Mich. P.A. 1970

STATE OF MICHIGAN
COUNTY OF BARRY
RECEIVED FOR RECORD

JUL 8 12 42 PM '94

**COMMISSION
BARRY**

For corners in

(County)

Located In: Corner Code ##

Sandy Schindelmar
REGISTER OF DEEDS

002202

1. Public Land Survey
T 2N R 9W M-9
T HOPE TWNSP.
COR. TWNSP. LINE SEC. 24 & 25
T _____ R _____
2. Property Controlling in Section
S _____ T _____ R _____
S _____ T _____ R _____
3. Miscellaneous Property in Sec.
S _____ T _____ R _____
S _____ T _____ R _____
4. Lot No. _____, Recorded Plat _____
5. Private Claims _____

Register of Deeds Stamp & File Number

I, **BRIAN REYNOLDS**, in a field survey on 06 APR, 1994, do hereby certify that under requirements of P.A. 74, Michigan P.A. of 1970, the corner points mentioned in lines 1 and 2 above were in conformance with regulations and rules therefore as required in the current manual of survey instructions of the United States Department of the Interior, Bureau of Land Management or by a decree of a Court of Law and/or that the corner points mentioned in lines 3, 4 and 5 above were in conformance with the rules of the Michigan Board of Land Surveyors or by a Decree of a Court of Law; established, re-established, monumented, re-monumented, recovered, found as expressed below:

NOTE: Not more than 4 corners, all in the same town and range, may be recorded on this certificate.

	A	B	C	D	E	F	G	H	I	J	K	L	M
2	6	5	4	3	2	1							
3													
4	7	8	9	10	11	12							
5													
6	18	17	16	15	14	13							
7													
8	19	20	21	22	23	24							
9													
10	30	29	28	27	26	25							
11													
12	31	32	33	34	35	36							
13													

A. Description of original monument and accessories and/or subsequent restoration:

- G.L.O.: JOHN MULLETT D.S., 1826, (R9W, Pg. 54-55):
BEECH - 9 - S15 1/2W - 106lnks.; Do. - 9 - N10 1/2W - 70lnks.
- SETH PRATT, 18-19 APR 1883, (L.2, Pg. 228):
LARGE STONE FOR CORNER, 8x8x12 INCHES:
W. O. - 12 - N9 1/2W - 1.47 3/4


B. Description of corner evidence found and/or method applied in restoring or reestablishing corner:

- WITH HELP FROM Co. ROAD COMMISSION EXCAVATED IN ROAD IN LINE WITH TOWNSHIP LINE FENCE TO NORTH. FOUND CIRCLE OF BRICK, BUT NO STONE AS PRATT, 1883, CALLED FOR. DETERMINED BRICK TO BE THAT OF PRATT. STONE MUST HAVE BEEN REMOVED AT TIME OF ROAD CONSTRUCTION. SET BARRY COUNTY REMONUMENTATION MONUMENT IN CENTER OF CIRCLED BRICKS. SEARCH FOR CLOSING CORNER FOR BALTIMORE TOWNSHIP, GOV'T JOG PLACING IT 14 lnks. NORTH = 9.24 FEET, TURNED UP NOTHING.

ACT 345 BARRY COUNTY REMONUMENTATION
APPROVED BY PEER REVIEW AT A MEETING HELD ON
APRIL 19 1994 BR
BRIAN REYNOLDS COUNTY SURVEYOR

C. Description of monument for corner and accessories established to perpetuate locating the position of the corner:

- SET BARRY Co. REMONUMENTATION MONUMENT IN CIRCLE OF BRICKS:
- MONUMENT SET OVER ANOTHER BARRY Co. MONUMENT
- +/- C/L CLOVERDALE ROAD
- IN LINE WITH FENCE TO NORTH
- N&T - E. SIDE - 24" BLACK WALNUT - DUE SOUTH - 23.47'
- N&T - NW. FACE - 18" BLACK WALNUT - S45W - 50.39'
- N&T - SW. FACE - AT BASE OF 14" BLACK WALNUT - N45W - 43.84'
- N&T - SE. FACE - 20" BLACK WALNUT - N30E - 42.39'

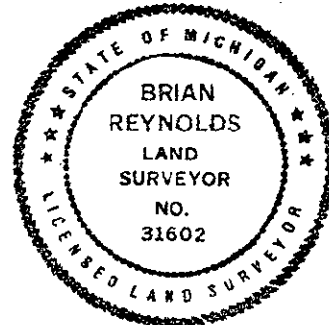

Signed by [Signature]
Surveyor's Michigan License No. 31602

Date JUNE 20, 1994