SURVEY & REMONUMENTATION

APR 08 1996

COMMISSION

STATE OF MICHIGAN
COUNTY OF BARRY
RECEIVED FOR RECORD

NOV 20 9 08 AM '95

Sandy Schondelmayer
REGISTER OF DEEDS

002329

Register of Deeds Stamp & File Number

LAND CORNER RECORDATION CERTIFICATE

Filing Requirement of Act 74, Mich. P.A. 1970

For corners in Barry (County)

	Located In:	Corner Code ##
1. Public Land Survey	T 2N R 10W	A-3 (SW, 6)
	T ___ R ___	Orangeville Twp.
	T ___ R ___	
	T ___ R ___	
2. Property Controlling	S ___ T ___ R ___	
in Section	S ___ T ___ R ___	
3. Miscellaneous	S ___ T ___ R ___	
Property in Sec.	S ___ T ___ R ___	

4. Lot No. _____, Recorded Plat _____
5. Private Claims _____

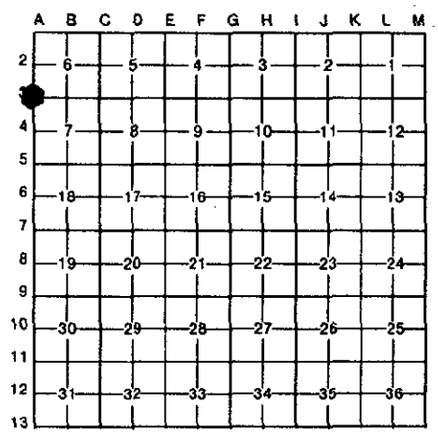

I, John C. Bueche, in a field survey on July, 19 95, do hereby certify that under requirements of P.A. 74, Michigan P.A. of 1970, the corner points mentioned in lines 1 and 2 above were in conformance with regulations and rules therefore as required in the current manual of survey instructions of the United States Department of the Interior, Bureau of Land Management or by a decree of a Court of Law and/or that the corner points mentioned in lines 3, 4 and 5 above were in conformance with the rules of the Michigan Board of Land Surveyors or by a Decree of a Court of Law; established, re-established, monumented, re-monumented, recovered, found as expressed below:

NOTE: Not more than 4 corners, all in the same town and range, may be recorded on this certificate.

A. Description of original monument and accessories and/or subsequent restoration:

A-3 GLO Sylvester Sibley, DS 1827
Intersected W boundary
75' S of post
Set Tamarek 10 Post

LCRC #212, May, 1977
Set T iron on line gov't. dist.
S of NE cor. Sec. 12
PP N 30 E 90.90'
PP N 85 E 68.73'
PP N 45 W 143.73'
SE cor. Sec. 1, 2-11, N 49.5'

B. Description of corner evidence found and/or method applied in restoring or reestablishing corner:

A-3 Found bent T iron @ grade

PP N 30 E 90.90'

And is accepted as a careful and faithful perpetuation of the position of the original corner.

ACT 345 BARRY COUNTY REMONUMENTATION
APPROVED BY PEER REVIEW AT A MEETING HELD ON
AUGUST 14, 1995 BR
BRIAN REYNOLDS COUNTY SURVEYOR

C. Description of monument for corner and accessories established to perpetuate locating the position of the corner:

A-3 Bent T iron @ grade (Remon. iron not installed)
C/L cor. fence post N 10 W 147.06'
C/L cor. fence post N 20 W 90.40'
C/L cor. fence post N 60 W 144.88'
Nail & Allegan Co. Remon. Tag in S side PP N 30 E 90.91'
C/L gravel rd. N-S, West 9'±
C/L gravel rd. West, North 50'±
Allegan. Co. Mon. SW cor. 1, 2-11, North 49.48'

STATE OF MICHIGAN
JOHN C. BUECHE
LAND SURVEYOR
No. 13027
REGISTERED LAND SURVEYOR

Signed by John C Bueche
John C. Bueche
Date oct 2, 1995

Surveyor's Michigan License No. 13027

FORM APPROVED BY MICHIGAN STATE BOARD OF LAND SURVEYORS, JAN. 28, 1971
REVISED MAY 14, 1975
REVISED JAN., 1983