

MAY 28 1997

COMMISSION

Barry County Remonumentation
LAND CORNER RECORDATION CERTIFICATE
Filing Requirement of Act 74, Mich. P.A. 1970

STATE OF MICHIGAN
COUNTY OF BARRY
RECEIVED FOR RECORD

DEC 7 2 04 PM '93

Sandy Schindelmayer
REGISTER OF DEEDS

002096

Register of Deeds Stamp & File Number

For corners in

| Barry (County) | Located In: | Corner Code # |
|---------------------------------------|-------------------|---------------------------------|
| 1. Public Land Survey | T 2N R 10W | C-1 (NE, 6) Orangeville Twp. |
| | T ___ R ___ | _____ |
| | T ___ R ___ | _____ |
| | T ___ R ___ | _____ |
| 2. Property Controlling in Section | S ___ T ___ R ___ | _____ |
| | S ___ T ___ R ___ | _____ |
| 3. Miscellaneous Property in Sec. | S ___ T ___ R ___ | _____ |
| | S ___ T ___ R ___ | _____ |

- 4. Lot No. _____, Recorded Plat _____
- 5. Private Claims _____

I, John C. Bueche, in a field survey on March, 1993, do hereby certify that under requirements of P.A. 74, Michigan P.A. of 1970, the corner points mentioned in lines 1 and 2 above were in conformance with regulations and rules therefore as required in the current manual of survey instructions of the United States Department of the Interior, Bureau of Land Management or by a decree of a Court of Law and/or that the corner points mentioned in lines 3, 4 and 5 above were in conformance with the rules of the Michigan Board of Land Surveyors or by a Decree of a Court of Law; established, re-established, monumented, re-monumented, recovered, found as expressed below:

| | | | | | | | | | | | | | |
|----|----|----|----|----|----|----|---|---|---|---|---|---|---|
| | A | B | C | D | E | F | G | H | I | J | K | L | M |
| 2 | 6 | 5 | 4 | 3 | 2 | 1 | | | | | | | |
| 3 | | | | | | | | | | | | | |
| 4 | 7 | 8 | 9 | 10 | 11 | 12 | | | | | | | |
| 5 | | | | | | | | | | | | | |
| 6 | 18 | 17 | 16 | 15 | 14 | 13 | | | | | | | |
| 7 | | | | | | | | | | | | | |
| 8 | 19 | 20 | 21 | 22 | 23 | 24 | | | | | | | |
| 9 | | | | | | | | | | | | | |
| 10 | 30 | 29 | 28 | 27 | 26 | 25 | | | | | | | |
| 11 | | | | | | | | | | | | | |
| 12 | 31 | 32 | 33 | 34 | 35 | 36 | | | | | | | |
| 13 | | | | | | | | | | | | | |

NOTE: Not more than 4 corners, all in the same town and range, may be recorded on this certificate.

A. Description of original monument and accessories and/or subsequent restoration:


C-1 Found pipe raised with 1/2" iron (Reynolds)
SE cor. 6 (3-10) W 12.51'
16" Oak N 70° W 16.10'
20" Oak S 30° E 22.70'
Utility pole S 85° W 8.83'

B. Description of corner evidence found and/or method applied in restoring or reestablishing corner:

C-1 Found 1/2" iron
Nail & #31602 cap in S side 22" Oak N 70° W 16.10'
Nail & #31602 cap in W side 24" Oak S 30° E 22.70'
Nail & #31602 cap in N side of utility pole S 85° W 8.87'
SE cor. 6 (3-10) W 12.51'

C. Description of monument for corner and accessories established to perpetuate locating the position of the corner:

C-1 Replaced 1/2" iron with Barry Co. Mon. (3/4" x 24" pin with alum. cap)
Nail & #31602 cap in N side utility pole S 85° W 8.87'
SE cor. bldg. alum. N 0° E 33.16'
SE cor. bldg. alum. N 70° E 58.18'
NW cor. wood hse. #11996 England Dr. S 15° E 82.32'
Conc. nail & B.C. Remon. Tag N side 16" Oak S 75° W 39.00'
SE cor. Sec. 31 (3-10) DNR Mon. West 12.51'
Meas. by hand

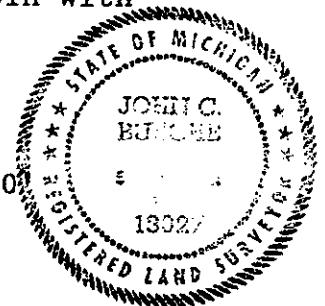

Signed by John C. Bueche Date Oct 29, 1993

Surveyor's Michigan License No. 13027