

1993

COMMISSION

Barry County Remonumentation
LAND CORNER RECORDATION CERTIFICATE
Filing Requirement of Act 74, Mich. P.A. 1970

STATE OF MICHIGAN
COUNTY OF BARRY
RECEIVED FOR RECORD

MAY 14 11 08 AM '93

Sandy Schondelmar
REGISTER OF DEEDS


For corners in

<u>Barry</u> (County)	Located In:	Corner Code #/
1. Public Land Survey	T <u>2N</u> R <u>10W</u>	D-7 (S 1/4, 17) Orangeville Twp.
	T _____ R _____	_____
	T _____ R _____	_____
	T _____ R _____	_____
2. Property Controlling in Section	S _____ T _____ R _____	_____
	S _____ T _____ R _____	_____
3. Miscellaneous Property in Sec.	S _____ T _____ R _____	_____
	S _____ T _____ R _____	_____
4. Lot No. _____, Recorded Plat _____		
5. Private Claims _____		

002002

Register of Deeds Stamp & File Number

I, John C. Bueche in a field survey on January, 1993, do hereby certify that under requirements of P.A. 74, Michigan P.A. of 1970, the corner points mentioned in lines 1 and 2 above were in conformance with regulations and rules therefore as required in the current manual of survey instructions of the United States Department of the Interior, Bureau of Land Management or by a decree of a Court of Law and/or that the corner points mentioned in lines 3, 4 and 5 above were in conformance with the rules of the Michigan Board of Land Surveyors or by a Decree of a Court of Law; established, re-established, monumented, re-monumented, recovered, found as expressed below:

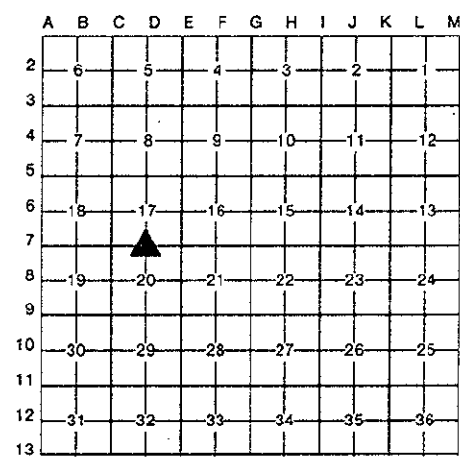


NOTE: Not more than 4 corners, all in the same town and range, may be recorded on this certificate.

A. Description of original monument and accessories and/or subsequent restoration:
 D-7 MDNR 1947 LCRC #46, Dec., 1972 DNR mon. with
 Established cor. from boundary brass cap date 1947
 lines 3" steel post S 45° W 0.25'
 No statement if anything set 3" Pine W 6.9'
 No wit. given 5" Oak N 40° W 12.0'
 LCRC #158, Jan., 1975 18" Walnut N 20° E 39.0'
 DNR mon. no wit. given 18" Hickory N 85° E 19.8'
 12" Cedar S 25° E 12.7'
 NW cor. conc. wall grave plot
 S 80° E 19.3'

B. Description of corner evidence found and/or method applied in restoring or reestablishing corner:
 D-7 Found MDNR mon. As per above wit.
 date 1947

C. Description of monument for corner and accessories established to perpetuate locating the position of the corner:
 D-7 MDNR mon. dated 1947
 3" x 6' steel post (yellow) S 45° W 0.25'
 40d nail in S side 8" Oak N 40° W 12.38'
 40d nail in N side 8" Pine N 90° W 7.03'
 40d nail in W side 10" Oak S 20° W 20.21'
 40d nail in SW side 14" Cedar S 25° E 12.88'
 40d nail in E side 24" Oak N 20° E 40.05'
 Top NW cor. conc. wall around grave plot "Cook" S 80° E 47.75'
 C/L road E-W into cemetery N 120'±; bit. rd. N-S, West 400'±
 Meas. by hand

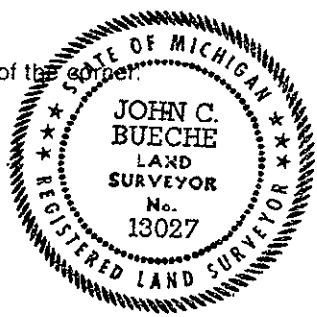

Signed by John C. Bueche Date 1-27-93

Surveyor's Michigan License No. 13027