

**SURVEY & REMONUMENTATION**

1993

**COMMISSION**

**Barry County Remonumentation  
LAND CORNER RECORDATION CERTIFICATE  
Filing Requirement of Act 74, Mich. P.A. 1970**

STATE OF MICHIGAN  
COUNTY OF BARRY  
RECEIVED FOR RECORD

May 14 11 08 AM '93

Sandy Schondelmayer

REGISTER OF DEEDS

**002003**

Register of Deeds Stamp & File Number

For corners in

Barry

(County)

Located In:

Corner Code #

- |                                       |                          |                  |
|---------------------------------------|--------------------------|------------------|
| 1. Public Land Survey                 | T <u>2N</u> R <u>10W</u> | D-9 (S 1/4, 20)  |
|                                       | T _____ R _____          | Orangeville Twp. |
|                                       | T _____ R _____          | _____            |
|                                       | T _____ R _____          | _____            |
| 2. Property Controlling in Section    | S _____ T _____ R _____  | _____            |
|                                       | S _____ T _____ R _____  | _____            |
| 3. Miscellaneous Property in Sec.     | S _____ T _____ R _____  | _____            |
|                                       | S _____ T _____ R _____  | _____            |
| 4. Lot No. _____, Recorded Plat _____ |                          |                  |
| 5. Private Claims _____               |                          |                  |

I, John C. Bueche in a field survey on January 19 93, do hereby certify that under requirements of P.A. 74, Michigan P.A. of 1970, the corner points mentioned in lines 1 and 2 above were in conformance with regulations and rules therefore as required in the current manual of survey instructions of the United States Department of the Interior, Bureau of Land Management or by a decree of a Court of Law and/or that the corner points mentioned in lines 3, 4 and 5 above were in conformance with the rules of the Michigan Board of Land Surveyors or by a Decree of a Court of Law; established, re-established, monumented, re-monumented, recovered, found as expressed below:

**NOTE: Not more than 4 corners, all in the same town and range, may be recorded on this certificate.**

	A	B	C	D	E	F	G	H	I	J	K	L	M
2	6	5	4	3	2	1							
3													
4	7	8	9	10	11	12							
5													
6	18	17	16	15	14	13							
7													
8	19	20	21	22	23	24							
9													
10	30	29	28	27	26	25							
11													
12	31	32	33	34	35	36							
13													

A. Description of original monument and accessories and/or subsequent restoration:


D-9 Found cor. in fence line Well marked by large stone Set 4" x 60" conc. post with brass plate No wit. given	LCRC #160, July, 1975 MDNR mon. Nail W side 30" Maple N 40° W 13.83' Nail S side 26" Oak W 25.05' Nail S side 12" Cherry E 24.25' C/L creek East 40'
--	---

B. Description of corner evidence found and/or method applied in restoring or reestablishing corner:

D-9 Found MDNR mon. dated 1947	30" Maple N 40° W 13.83' (dead) 12" W. Cherry East 24.25'± (stump) 26" Oak West 25'± C/L creek East 40'±
--------------------------------	---

C. Description of monument for corner and accessories established to perpetuate locating the position of the corner:

D-9 MDNR mon. dated 1947  
Blaze & 40d nail in N'ly side 12" Oak S 60° E 12.58'  
Blaze & 40d nail in N side 4" W. Cherry N 80° E 13.18'  
Blaze & 40d nail in S side 14" Ash N 45° W 42.05'  
Blaze & 40d nail in N side 10" Catalpa S 70° W 7.47'  
Blaze & 40d nail in E side 8" Ash N 40° E 20.20'  
C/L creek East 40'±  
Meas. by hand

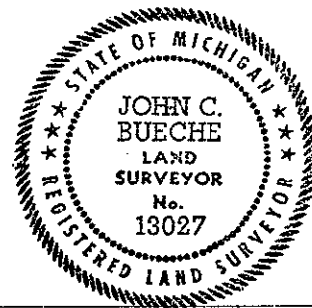

Signed by John C Bueche Date 1-27-93

Surveyor's Michigan License No. 13027