

**SURVEY & REMONUMENTATION**

1993

**COMMISSION**

**BARRY COUNTY REMONUMENTATION  
LAND CORNER RECORDATION CERTIFICATE  
Filing Requirement of Act 74, Mich. P.A. 1970**

STATE OF MICHIGAN  
COUNTY OF BARRY  
RECEIVED FOR RECORD

MAY 14 11:08 AM '93

Sandy Schondelmayer

REGISTER OF DEEDS

For corners in

<u>BARRY</u> (County)	Located In:	Corner Code #
	<b>ORANGEVILLE</b>	
1. Public Land Survey	T <u>2N</u> R <u>10W</u>	<u>F-5</u>
	T _____ R _____	_____
	T _____ R _____	_____
	T _____ R _____	_____
2. Property Controlling in Section	S _____ T _____ R _____	_____
	S _____ T _____ R _____	_____
3. Miscellaneous Property in Sec.	S _____ T _____ R _____	_____
	S _____ T _____ R _____	_____

**002010**

Register of Deeds Stamp & File Number

4. Lot No. \_\_\_\_\_, Recorded Plat \_\_\_\_\_  
5. Private Claims \_\_\_\_\_

	A	B	C	D	E	F	G	H	I	J	K	L
2	6	5	4	3	2	1						
3												
4	7	8	9	10	11	12						
5												
6	18	17	16	15	14	13						
7												
8	19	20	21	22	23	24						
9												
10	30	29	28	27	26	25						
11												
12	31	32	33	34	35	36						
13												

I, John C. Bueche, in a field survey on January, 1993, do hereby certify that under requirements of P.A. 74, Michigan P.A. of 1970, the corner points mentioned in lines 1 and 2 above were in conformance with regulations and rules therefore as required in the current manual of survey instructions of the United States Department of the Interior, Bureau of Land Management or by a decree of a Court of Law and/or that the corner points mentioned in lines 3, 4 and 5 above were in conformance with the rules of the Michigan Board of Land Surveyors or by a Decree of a Court of Law; established, re-established, monumented, re-monumented, recovered, found as expressed below:

**NOTE: Not more than 4 corners, all in the same town and range, may be recorded on this certificate.**

**A. Description of original monument and accessories and/or subsequent restoration:**

Michigan Department of Conservation 1947 Shadko found bottom of fence corner post at intersection of fences, set Monument 8" above ground, not witnessed. 1947 distance to E-5 2639.8	Van Kooten 1958 found Department of Conservation brass cap monument 12" Oak West 27.6' 8" Oak SE 30.3 10" Oak SSW 35.4 fence South and East 2640.6 to E-5 1958
---	--

LCRC # 467 Nov. 1992 Bueche concrete monument conc. nail NE side 14" Oak S40°W 21.45' conc. nail N side 12" Oak S70°E 11.54' conc. nail E side 8" Ash N5°E 30.37' conc. nail N side 8" Oak N85°W 22.10

Additional historical information on back of form


**B. Description of corner evidence found and/or method applied in restoring or reestablishing corner:**

Found Department of Conservation brass cap monument as recorded in LCRC# 467. Property owner to the Southwest testified that when he bought the land, C. 1972, the monument was lying flat on the surface. Inspected brass cap, found it to be top half only of 4' long monument. Checked Van Kooten witnesses, dug and found bottom half intact 8'± West of previously recorded position. Accepted as corner.

Found 24" Oak stump West 27.6± 20" Oak SE 30.3± 24" Oak SSW 35.4±	Distance E-5 to previously recorded position 2647.60' Distance E-5 to accepted position 2639.05'
--	---

**C. Description of monument for corner and accessories established to perpetuate locating the position of the corner:**

Bottom half DNR mon. replaced W/standard 36"X3/4" remon, iron and cap 1/2" re-rod W/orange (Reynolds Trav. point) cap, (previously recorded cor.) S81E - 8.61'  
Blaze & conc. nail - N. side - 12" Oak - S72E - 19.84'  
Blaze & conc. nail - NE. side - 14" Oak - S15W - 18.68'  
Blaze & conc. nail - N. side - 8" Oak - N88W - 13.55'  
Blaze & conc. nail - E. side - 8" Ash - N25E - 31.32'  
Blaze & 40 D nail - E. side - 12" Oak - N10W - 21.76'  
Blaze & 40 D nail - N. side - 14" Oak - N69E - 29.42'  
traces of old fence intersect, fe. S ±6'E., fe. E ±9'S.

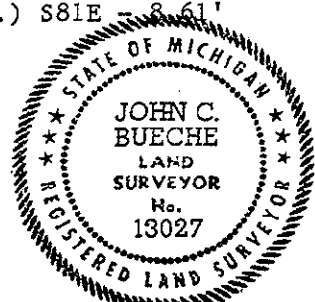

Signed by John C. Bueche Date January, 1993  
Surveyor's Michigan License No. 13027

Survey of Section 16 A.C. Willson May, 1867 L.2 P. 161  
"run the N & S quarter line" no monument or witnesses recited

Survey of Section 9 A.C. Willson January 7, 1868  
L. 2, P. 209 W. Oak 8 N60E 25  
D<sub>o</sub> 6 S42-1/2E 90  
no monument recited

Survey of Section 9 Frank S. Bowen May, 1875  
L. 1, P. 86-87 no monument or witnesses recited