

**SURVEY &
REMONUMENTATION**

1993

COMMISSION

**Barry County Remonumentation
LAND CORNER RECORDATION CERTIFICATE
Filing Requirement of Act 74, Mich. P.A. 1970**

STATE OF MICHIGAN
COUNTY OF BARRY
RECEIVED FOR RECORD

MAY 14 11 08 AM '93

Sandy Schondelmayer
REGISTER OF DEEDS

For corners in

Barry

(County)

Located In:

Corner Code #


- | | | | | | |
|---------------------------------------|---|----|---|-----|------------------|
| 1. Public Land Survey | T | 2N | R | 10W | F-9 (S 1/4, 21) |
| | T | | R | | Orangeville Twp. |
| | T | | R | | |
| | T | | R | | |
| 2. Property Controlling in Section | S | | T | | R |
| | S | | T | | R |
| 3. Miscellaneous Property in Sec. | S | | T | | R |
| | S | | T | | R |
4. Lot No. _____, Recorded Plat _____
5. Private Claims _____

002011

Register of Deeds Stamp & File Number

I, John C. Bueche, in a field survey on January, 1993, do hereby certify that under requirements of P.A. 74, Michigan P.A. of 1970, the corner points mentioned in lines 1 and 2 above were in conformance with regulations and rules therefore as required in the current manual of survey instructions of the United States Department of the Interior, Bureau of Land Management or by a decree of a Court of Law and/or that the corner points mentioned in lines 3, 4 and 5 above were in conformance with the rules of the Michigan Board of Land Surveyors or by a Decree of a Court of Law; established, re-established, monumented, re-monumented, recovered, found as expressed below:

NOTE: Not more than 4 corners, all in the same town and range, may be recorded on this certificate.

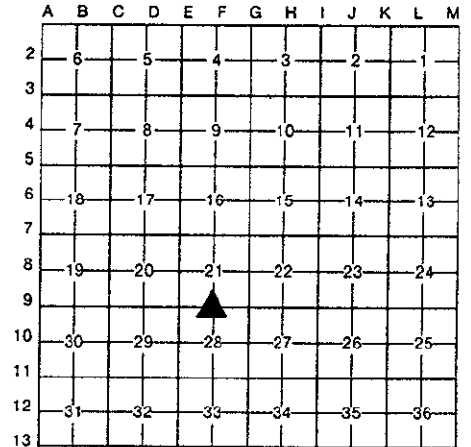

A. Description of original monument and accessories and/or subsequent restoration:

| | |
|-------------------------------|---------------------------------|
| F-9 MDNR 1947 | LCRC #233, March, 1978 |
| Set 4" x 60" conc. post with | 15" Oak S 30° E 4.56' |
| brass plate @ intersection of | 15" Oak S 50° W 20.59' |
| fences & also painted white | Triple 18" Maple N 65° W 16.30' |
| cedar post 5" x 7' | |
| No wit. given | |


B. Description of corner evidence found and/or method applied in restoring or reestablishing corner:

| | |
|--------------------------------|------------------------|
| F-9 Found MDNR mon. dated 1947 | 15" Oak S 30° E 4.56' |
| On line of fence post N | 15" Oak S 50° W 20.59' |
| On S edge of woods E | |
| On W edge of woods S | |

C. Description of monument for corner and accessories established to perpetuate locating the position of the corner:

F-9 MDNR mon. dated 1947

- Blaze & 40d nail in S side 28" Beech N 65° W 32.20'
- Blaze & 40d nail in E side dbl. 22" Oak N 15° W 50.90'
- Blaze & 40d nail in W side 18" Oak S 30° E 4.97'
- Blaze & 40d nail in W side 18" Oak S 55° W 20.70'
- Blaze & 40d nail in S side 18" Oak S 80° E 46.40'
- Blaze & 40d nail in SE side 10" Oak N 40° E 31.75'
- Meas. by hand

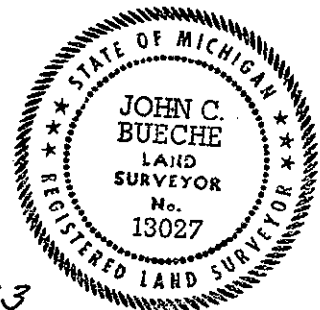

Signed by John C Bueche

Date 1-27-93

Surveyor's Michigan License No. 13027