MAY 2 2 1997

STATE OF MICHIGAN
COUNTY OF BARRY
RECEIVED FOR RECORD
DEC 7 2 04 PM '93
Sandy Schondelmayer
REGISTER OF DEEDS

002097

Register of Deeds Stamp & File Number

Barry County Remonumentation
LAND CORNER RECORDATION CERTIFICATE
Filing Requirement of Act 74, Mich. P.A. 1970

For corners in Barry (County)

	Located In:	Corner Code ##
1. Public Land Survey	T 2N R 10W	G-1 (NE, 4)
	T ___ R ___	Orangeville Twp.
	T ___ R ___	
	T ___ R ___	
2. Property Controlling	S ___ T ___ R ___	
in Section	S ___ T ___ R ___	
3. Miscellaneous	S ___ T ___ R ___	
Property in Sec.	S ___ T ___ R ___	

4. Lot No. _____, Recorded Plat _____
5. Private Claims _____

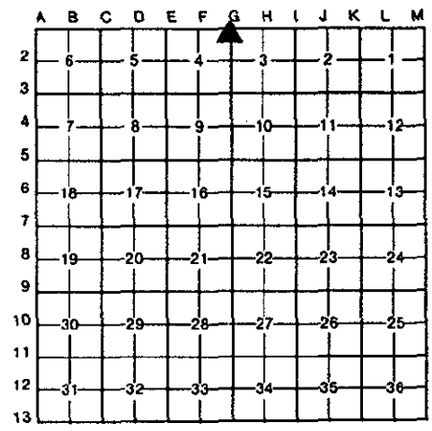

I, John C. Bueche, in a field survey on March, 19 93, do hereby certify that under requirements of P.A. 74, Michigan P.A. of 1970, the corner points mentioned in lines 1 and 2 above were in conformance with regulations and rules therefore as required in the current manual of survey instructions of the United States Department of the Interior, Bureau of Land Management or by a decree of a Court of Law and/or that the corner points mentioned in lines 3, 4 and 5 above were in conformance with the rules of the Michigan Board of Land Surveyors or by a Decree of a Court of Law; established, re-established, monumented, re-monumented, recovered, found as expressed below:

NOTE: Not more than 4 corners, all in the same town and range, may be recorded on this certificate.

A. Description of original monument and accessories and/or subsequent restoration:

G-1 4" x 30" conc. Mon. with alum. cap (Reynolds)
N 52° E 32.92' 5" B. Oak
S 30° E 32.95' 11" W. Oak
S 14° W 19.39' 5" Hickory
West 16.5' conc. Mon. SW Sec. 34

B. Description of corner evidence found and/or method applied in restoring or reestablishing corner:

G-1 Found conc. Mon. with DNR cap at fence South & West
As per above wit.

C. Description of monument for corner and accessories established to perpetuate locating the position of the corner:

G-1 Conc. Mon. with DNR cap
Nail & B.C. Remon. Tag in SW side 8" Oak N 40° W 20.52'
Nail & B.C. Remon. Tag in S side 14" Oak N 85° E 19.94'
Nail & B.C. Remon. Tag in SE side 10" Ash S 30° E 13.78'
Nail & B.C. Remon. Tag in E side 10" Oak S 15° W 19.10'
Nail & B.C. Remon. Tag in S side 10" Oak N 70° W 26.18'
Fence cor. W & S is South 1.3'±
Conc. Mon. with DNR cap (SW 34, 3-10) West 16.50'
Meas. by hand

STATE OF MICHIGAN
JOHN C. BUECHE
LAND SURVEYOR
No. 13027
REGISTERED LAND SURVEYOR

Signed by John C Bueche Date oct 29, 1993

Surveyor's Michigan License No. 13027

FORM APPROVED BY MICHIGAN STATE BOARD OF LAND SURVEYORS, JAN. 28, 1971
REVISED MAY 14, 1975
REVISED JAN., 1983