

STATE OF MICHIGAN
COUNTY OF BARRY
RECEIVED FOR RECORD

DEC 7 2 04 PM '93

Sandy Schondelmar
REGISTER OF DEEDS

Barry County Remonumentation
LAND CORNER RECORDATION CERTIFICATE
Filing Requirement of Act 74, Mich. P.A. 1970

For corners in

Barry

(County)

Located In:

Corner Code #

1. Public Land Survey

T 2N R 10W

G-2(E 1/2, 4)

T R

Orangeville Twp.

T R

T R

2. Property Controlling
in Section

S T R

S T R

3. Miscellaneous
Property in Sec.

S T R

S T R

002098

Register of Deeds Stamp & File Number

4. Lot No. _____, Recorded Plat _____

5. Private Claims _____

	A	B	C	D	E	F	G	H	I	J	K	L	M
2	6	5	4	3	2	1							
3													
4	7	8	9	10	11	12							
5													
6	18	17	16	15	14	13							
7													
8	19	20	21	22	23	24							
9													
10	30	29	28	27	26	25							
11													
12	31	32	33	34	35	36							
13													

I, John C. Bueche in a field survey on March, 19 93

do hereby certify that under requirements of P.A. 74, Michigan P.A. of 1970, the corner points mentioned in lines 1 and 2 above were in conformance with regulations and rules therefore as required in the current manual of survey instructions of the United States Department of the Interior, Bureau of Land Management or by a decree of a Court of Law and/or that the corner points mentioned in lines 3, 4 and 5 above were in conformance with the rules of the Michigan Board of Land Surveyors or by a Decree of a Court of Law; established, re-established, monumented, re-monumented, recovered, found as expressed below:

NOTE: Not more than 4 corners, all in the same town and range, may be recorded on this certificate.

A. Description of original monument and accessories and/or subsequent restoration:

G-2 Conc. Mon. in Mon. Box in blacktop road (Reynolds)
N 53° E 48.74' 16" Walnut
N 23° W 41.31' 10" B. Oak
N 73° W 107.5' PP

SURVEY &
REMONUMENTATION

APR 05 1994


COMMISSION

B. Description of corner evidence found and/or method applied in restoring or reestablishing corner:

G-2 Found conc. Mon. with DNR cap in Mon. Box, on fence line
North & .5'± S of C/L bit.
N 23° W 41.31' 10" B. Oak

C. Description of monument for corner and accessories established to perpetuate locating the position of the corner:

G-2 Conc. Mon. with DNR cap in Mon. Box
Existing nail & cap #31602 in W side 12" Oak N 30° W 41.26'
Nail & B.C. Remon. Tag in NW side 12" Ash N 44° E 75.27'
Nail & B.C. Remon. Tag in SE side 8" Ash N 60° E 93.42'
Nail & B.C. Remon. Tag in E side 8" Ash N 20° E 59.22'
Nail & B.C. Remon. Tag in N side 20" W. Cherry N 70° W 86.
C/L bit. E-W, North 5'±, on fence line North

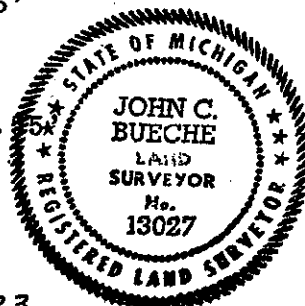

Signed by John C. Bueche

Date Oct 29, 1993

Surveyor's Michigan License No. 13027