

**SURVEY &  
REMONUMENTATION**

1993

**COMMISSION**

**Barry County Remonumentation  
LAND CORNER RECORDATION CERTIFICATE  
Filing Requirement of Act 74, Mich. P.A. 1970**

STATE OF MICHIGAN  
COUNTY OF BARRY  
RECEIVED FOR RECORD

MAY 14 11 08 AM '93

Sandy Schendelmarer  
REGISTER OF DEEDS

For corners in

Barry <small>(County)</small>	Located In:	Corner Code #/
1. Public Land Survey	T <u>2N</u> R <u>10W</u>	G-8 (E 1/4, 21) Orangeville Twp.
2. Property Controlling in Section	S _____ T _____ R _____	_____
3. Miscellaneous Property in Sec.	S _____ T _____ R _____	_____
4. Lot No. _____, Recorded Plat _____		
5. Private Claims _____		

**002014**

Register of Deeds Stamp & File Number

I, John C. Bueche, in a field survey on January, 1993, do hereby certify that under requirements of P.A. 74, Michigan P.A. of 1970, the corner points mentioned in lines 1 and 2 above were in conformance with regulations and rules therefore as required in the current manual of survey instructions of the United States Department of the Interior, Bureau of Land Management or by a decree of a Court of Law and/or that the corner points mentioned in lines 3, 4 and 5 above were in conformance with the rules of the Michigan Board of Land Surveyors or by a Decree of a Court of Law; established, re-established, monumented, re-monumented, recovered, found as expressed below:

	A	B	C	D	E	F	G	H	I	J	K	L	M
2	6	5	4	3	2	1							
3													
4	7	8	9	10	11	12							
5													
6	18	17	16	15	14	13							
7													
8	19	20	21	22	23	24							
9													
10	30	29	28	27	26	25							
11													
12	31	32	33	34	35	36							
13													

**NOTE: Not more than 4 corners, all in the same town and range, may be recorded on this certificate.**

A. Description of original monument and accessories and/or subsequent restoration:


G-8 MDNR 1947 Nothing recorded  
 Found 1/2" rod in center of road,  
 also rotted remains of 1876 5" Maple  
 N 44 1/2 E 41 1/2 Lks. by Bowen  
 Set 4" x 60" conc. post with brass plate  
 12" below surface  
 "V" notch in face 22" Elm N 54-15 W 23.55'  
 "V" notch in face 12" Elm N 2-30 E 53.2'

B. Description of corner evidence found and/or method applied in restoring or reestablishing corner:

G-8 Found broken conc. mon. @ surface of gravel road  
 On line of fence post South  
 C/L E-W gravel road South 2'±  
 On C/L drive North to hse. #10102

C. Description of monument for corner and accessories established to perpetuate locating the position of the corner:

G-8 Set PK in top broken conc. mon.  
 Conc. nail in N side PP S 80° W 143.01'  
 Conc. nail in E side 12" Elm N 25° W 72.32'  
 Conc. nail in E side 10" W. Cherry N 15° E 59.06'  
 Conc. nail in SE side 12" Elm N 35° E 36.82'  
 Conc. nail in S side 14" Oak N 85° E 139.61'  
 C/L E-W gravel road South 2'±  
 On C/L drive North to hse. #10102  
 Meas. by hand

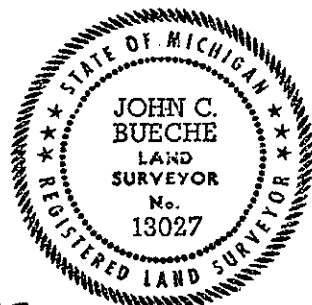

Signed by John C. Bueche Date 1-27-93  
 Surveyor's Michigan License No. 13027