

**SURVEY & REMONUMENTATION**

AUG 31 1994

COMMISSION

For corners in BARRY  
(County)

**BARRY COUNTY REMONUMENTATION  
LAND CORNER RECORDATION CERTIFICATE  
Filing Requirement of Act 74, Mich. P.A. 1970**

Located In: \_\_\_\_\_ Corner Code # \_\_\_\_\_

1. Public Land Survey

T 2N R 10W H-5  
ORANGEVILLE TOWNSHIP  
T 1/4 COR. SEC. 10 & 15

2. Property Controlling in Section

S \_\_\_\_\_ T \_\_\_\_\_ R \_\_\_\_\_  
S \_\_\_\_\_ T \_\_\_\_\_ R \_\_\_\_\_

3. Miscellaneous Property in Sec.

S \_\_\_\_\_ T \_\_\_\_\_ R \_\_\_\_\_  
S \_\_\_\_\_ T \_\_\_\_\_ R \_\_\_\_\_

4. Lot No. \_\_\_\_\_, Recorded Plat \_\_\_\_\_

5. Private Claims \_\_\_\_\_

STATE OF MICHIGAN  
COUNTY OF BARRY  
RECEIVED FOR RECORD

JUL 8 12 42 PM '94

Sandy Schindelmaier  
REGISTER OF DEEDS

002201

Register of Deeds Stamp & File Number

**BRIAN REYNOLDS**

15 APR

94

I, BRIAN REYNOLDS, in a field survey on 15 APR, 1994, do hereby certify that under requirements of P.A. 74, Michigan P.A. of 1970, the corner points mentioned in lines 1 and 2 above were in conformance with regulations and rules therefore as required in the current manual of survey instructions of the United States Department of the Interior, Bureau of Land Management or by a decree of a Court of Law and/or that the corner points mentioned in lines 3, 4 and 5 above were in conformance with the rules of the Michigan Board of Land Surveyors or by a Decree of a Court of Law; established, re-established, monumented, re-monumented, recovered, found as expressed below:

NOTE: Not more than 4 corners, all in the same town and range, may be recorded on this certificate.

	A	B	C	D	E	F	G	H	I	J	K	L	M
2	6		5		4		3		2		1		
3													
4	7		8		9		10		11		12		
5								⊕					
6	18		17		16		15		14		13		
7													
8	19		20		21		22		23		24		
9													
10	30		29		28		27		26		25		
11													
12	31		32		33		34		35		36		

- A. Description of original monument and accessories and/or subsequent restoration:
- G.L.O.: SYLVESTER SIBLEY D.S., 1827, (R10W, Pg. 86): WEST CORRECTED 39.92chains  
W. OAK - 18 - S48E - 44; B. OAK - 16 - N8W - 52.
  - A.C. WILLSON, MAR 1867, (L.2, Pg.135): FOUND POST TOOK NEW BEARINGS.  
W. OK - 30 - N22E - 57 1/2; Do. - 16 - S33W - 92.
  - A.C. WILLSON, 28 MAY 1867, (L.2, Pg. 211): BEARINGS FOUND.

-SURVEY OF SECTION 10 BY KING AND CARR, INC., C. 1982, NO WITNESSES AVAILABLE

B. Description of corner evidence found and/or method applied in restoring or reestablishing corner:

- FOUND 1/2" CAPPED IRON AT FENCE CORNER: P.S. # 20704, ROBERT R. CARR

FOUND NO OTHER EVIDENCE OF PREVIOUS MONUMENTATION.


ACCEPTED FOUND 1/2" IRON AS BEST EVIDENCE OF CORNER POSITION.

ACT 345 BARRY COUNTY REMONUMENTATION  
APPROVED BY PEER REVIEW AT A MEETING HELD ON

MAY 3, 1994 BR  
BRIAN REYNOLDS COUNTY SURVEYOR

C. Description of monument for corner and accessories established to perpetuate locating the position of the corner:

- SET BARRY Co. REMONUMENTATION MONUMENT IN PLACE OF FOUND 1/2" IRON:
- AT FENCE CORNER, FENCES N. - S. - E. - W.
- N&T - NE. FACE - 24" OAK - S10E - 19.23'
- N&T - SW. FACE - 8" OAK - N45W - 27.28'
- N&T - NW. FACE - 12" BASSWOOD - N10E - 36.21'
- N&T - N. FACE - 16" BASSWOOD - S70E - 65.25'

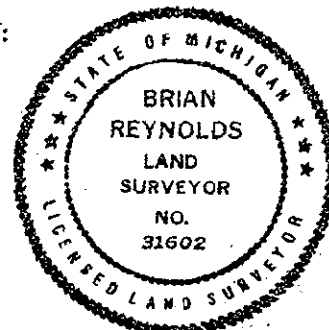

Signed by [Signature]  
Surveyor's Michigan License No. 31602

Date JUNE 20, 1994