

**SURVEY & REMONUMENTATION**

AUG 3 1 1994

COMMISSION

**BARRY COUNTY REMONUMENTATION  
LAND CORNER RECORDATION CERTIFICATE  
Filing Requirement of Act 74, Mich. P.A. 1970**

STATE OF MICHIGAN  
COUNTY OF BARRY  
RECEIVED FOR RECORD

JUL 8 12 42 PM '94

Sandy Schondelmar  
REGISTER OF DEEDS

002199

Register of Deeds Stamp & File Number

For corners in BARRY  
(County)

Located In: Corner Code #

1. Public Land Survey T 2N R 10W H-7  
ORANGEVILLE TOWNSHIP  
1/4 COR. SEC. 15 & 22  
T \_\_\_\_\_ R \_\_\_\_\_
2. Property Controlling in Section S \_\_\_\_\_ T \_\_\_\_\_ R \_\_\_\_\_  
S \_\_\_\_\_ T \_\_\_\_\_ R \_\_\_\_\_
3. Miscellaneous Property in Sec. S \_\_\_\_\_ T \_\_\_\_\_ R \_\_\_\_\_  
S \_\_\_\_\_ T \_\_\_\_\_ R \_\_\_\_\_
4. Lot No. \_\_\_\_\_, Recorded Plat \_\_\_\_\_
5. Private Claims \_\_\_\_\_

	A	B	C	D	E	F	G	H	I	J	K	L	M
2	6	5	4	3	2	1							
3													
4	7	8	9	10	11	12							
5													
6	18	17	16	15	14	13							
7													
8	19	20	21	22	23	24							
9													
10	30	29	28	27	26	25							
11													
12	31	32	33	34	35	36							
13													

I, BRIAN REYNOLDS, in a field survey on 15 APR, 1994, do hereby certify that under requirements of P.A. 74, Michigan P.A. of 1970, the corner points mentioned in lines 1 and 2 above were in conformance with regulations and rules therefore as required in the current manual of survey instructions of the United States Department of the Interior, Bureau of Land Management or by a decree of a Court of Law and/or that the corner points mentioned in lines 3, 4 and 5 above were in conformance with the rules of the Michigan Board of Land Surveyors or by a Decree of a Court of Law; established, re-established, monumented, re-monumented, recovered, found as expressed below:


**NOTE: Not more than 4 corners, all in the same town and range, may be recorded on this certificate.**

- A. Description of original monument and accessories and/or subsequent restoration:
- G.L.O.: SYLVESTER SIBLEY D.S., 1827, (R10W, Pg. 86):  
B. OAK - 8 - N58E - 20; W. OAK - 8 - S56W - 15.
  - A.C. WILLSON, 20 APR 1867, (L.2, Pg.150): FOUND OLD BEARINGS TOOK NEW ONES.  
W. OAK - 12 - S24W - 34; TAMARACK - 6 - N78W - 60 1/2
  - A.C. WILLSON, 24 APR 1867, (L.2, Pg.137): BY ORIGINAL BEARINGS.
  - WALTER HEATH, 8,9,10,27,28 OCT 1903, (L.3, Pg. 92): ESTABLISHED CORNER, RIFLE BARREL  
HICKORY - 4 - S35E - 48; WHITE OAK - 7 - S72W - 22 1/4.
  - INGERSOLL, WATSON & McMACHEN, INC., 22 JUN 1978: VARIFIED FENCE CORNER AS EVIDENCE OF SECTION CORNER LOCATION BY MEASUREMENTS WEST TO NW. COR. AND SOUTH TO CENTER. (SEE BACK OF FORM FOR WITNESSES)
- B. Description of corner evidence found and/or method applied in restoring or reestablishing corner:
- FOUND 1/2" CAPPED IRON AS PER I.W.M. NOTES. DUG TO FIND CIRCLE OF STONES IMMEDIATELY UNDER IRON.  
REMOVED IRON AND NEARBY FENCING TO SEARCH FOR RIFLE BARREL RECITED BY HEATH, FOUND NOTHING. ACCEPTED IRON BY INGERSOLL AS BEST AVAILABLE EVIDENCE OF CORNER LOCATION.

ACT 345 BARRY COUNTY REMONUMENTATION  
APPROVED BY PEER REVIEW AT A MEETING HELD ON  
MAY 3, 1994 BR  
BRIAN REYNOLDS COUNTY SURVEYOR

C. Description of monument for corner and accessories established to perpetuate locating the position of the corner:

- SET BARRY Co. REMONUMENTATION MONUMENT IN PLACE OF FOUND 1/2" IRON:
- IN CIRCLE OF STONES
- ON INTERSECTION OF FENCES N. - S. - E.
- N&T - SW. FACE - 10" OAK - N34W - 18.96'
- N&T - SW. FACE - 16" ASH - S30E - 36.09'
- N&T - S. FACE - 18" OAK - S69W - 20.73'

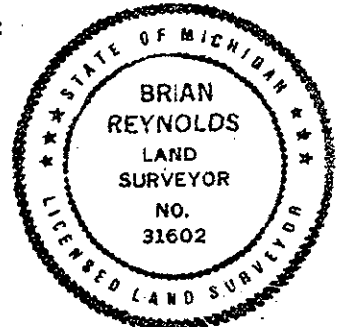

Signed by [Signature] Date JUNE 20, 1994  
Surveyor's Michigan License No. 31602

97824U

- WITNESSES TO I.W.M. 1/2" IRON:

30" OAK - N20E - 16.96'

10" OAK - S20W - 60.0'

TRI 6" OAK - S50E - 30.92'

12" OAK - WEST - 21.5'

SURVEY &  
REMONUMENTATION

AUG 31 1994

COMMISSION