

SURVEY & REMONUMENTATION

AUG 31 1994

**BARRY COUNTY REMONUMENTATION
LAND CORNER RECORDATION CERTIFICATE
Filing Requirement of Act 74, Mich. P.A. 1970**

STATE OF MICHIGAN
COUNTY OF BARRY
RECEIVED FOR RECORD

JUL 8 12 42 PM '94

For corners in **COMMISSION BARRY**

Sandy Schindelmarper
REGISTER OF DEEDS

Located In: _____ Corner Code ## _____

1. Public Land Survey T 2N R 10W I-7
ORANGEVILLE TWP.
COR. SEC. 14, 15, 22, & 23
 T _____ R _____

2. Property Controlling S _____ T _____ R _____
 in Section S _____ T _____ R _____

3. Miscellaneous S _____ T _____ R _____
 Property in Sec. S _____ T _____ R _____

002196

Register of Deeds Stamp & File Number

4. Lot No. _____, Recorded Plat _____
 5. Private Claims _____

	A	B	C	D	E	F	G	H	I	J	K	L	M
2	6	5	4	3	2	1							
3													
4	7	8	9	10	11	12							
5													
6	18	17	16	15	14	13							
7													
8	19	20	21	22	23	24							
9													
10	30	29	28	27	26	25							
11													
12	31	32	33	34	35	36							
13													

I, **BRIAN REYNOLDS**, in a field survey on 15 APR, 19 94, do hereby certify that under requirements of P.A. 74, Michigan P.A. of 1970, the corner points mentioned in lines 1 and 2 above were in conformance with regulations and rules therefore as required in the current manual of survey instructions of the United States Department of the Interior, Bureau of Land Management or by a decree of a Court of Law and/or that the corner points mentioned in lines 3, 4 and 5 above were in conformance with the rules of the Michigan Board of Land Surveyors or by a Decree of a Court of Law; established, re-established, monumented, re-monumented, recovered, found as expressed below:

NOTE: Not more than 4 corners, all in the same town and range, may be recorded on this certificate.

A. Description of original monument and accessories and/or subsequent restoration:

- G.L.O.: SYLVESTER SIBLEY D.S., 1827, (R10W, Pg. 81):
 W. OAK - 9 - S81W - 6; Do. - 9 - S17 1/2W - 31.
- A.C. WILLSON, 20 APR 1867, (L.2, Pg.150): FOUND BY U.S. BEARINGS.
- WALTER HEATH, 8,9,10,27,28 OCT 1903, (L.3, Pg. 92,93): FOUND STONE. SOUTH SIDE OF ANCHOR POST, NORTH END OF WIRE FENCE.
- INGERSOLL, WATSON, & McMACHEN, INC., 22 JUN 1978, SURVEY IN SEC. 22, ORANGEVILLE:
 SET IRON ROD: ESTABLISHED SECTION CORNER ON PROJECTION OF THE NORTH LINE OF THE NW1/4 AT THE PRORATION DETERMINED BETWEEN 1867 SURVEY AND NOW OF SAID NORTH LINE. (N1/8COR., NE1/4 COR. FALLS IN E. - W. FENCE. (SEE WIT. ON BACK OF THIS FORM)


B. Description of corner evidence found and/or method applied in restoring or reestablishing corner:

- FOUND 1/2" CAPPED IRON AS PER L.W.M. NOTES.
 ACCEPTED AS BEST AVAILABLE EVIDENCE OF CORNER LOCATION

ACT 345 BARRY COUNTY REMONUMENTATION
 APPROVED BY PEER REVIEW AT A MEETING HELD ON
MAY 3, 1994 BR
 BRIAN REYNOLDS COUNTY SURVEYOR

C. Description of monument for corner and accessories established to perpetuate locating the position of the corner:

- SET BARRY Co. REMONUMENTATION MONUMENT IN PLACE OF FOUND 1/2" IRON:
 - FND. SPIKE - W. FACE - 14" OAK - S30E - 26.95'
 - FND. SPIKE - N. FACE - 12" BLACK CHERRY - S80W - 23.48'
 - 3' N. OF FENCE TO WEST
 - 10.3' E. TO N. - S. FENCE
 - N&T - NE. FACE - NE. TRUNK - 12" DOUBLE BLACK CHERRY - N30W - 39.37'
 - N&T - W. FACE - 16" ELM - N15E - 66.23'
 - N&T - SW. FACE - 6" HICKORY - S50E - 13.35'
 - N&T - S. FACE - 16" OAK - S85W - 53.70'

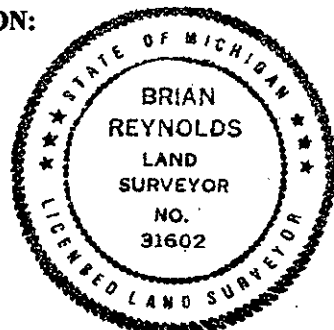

Signed by [Signature] Date JUNE 20, 1994
 Surveyor's Michigan License No. 31602

9782-14

I.W.M. WITNESSES TO SET 1/2" IRON:

- FND. SPIKE - 6" OAK - S80W - 53.70'
- FND. SPIKE - 6" OAK - S30E - 26.70'
- 3' N. OF FENCE TO WEST
- 10.3' E. TO N. - S. FENCE

**SURVEY &
REMONUMENTATION**

AUG 31 1994

COMMISSION