

APR 04 2000

SECTION

Barry County Remonumentation Program
LAND CORNER RECORDATION CERTIFICATE
Filing Requirement of Act 74, Mich. P.A. 1970

For corners in Orangeville Township Quarter Corner 2, 11

Barry (County)	Located in:	Corner Code #
1. Public Land Survey	T2N R10W	J3
	T R	
	T R	
	T R	
2. Property Controlling in Section	S T R	
	S T R	
3. Miscellaneous Property in Sec.	S T R	
	S T R	



2758

Page: 1 of
01/27/1999 03:1

Sandy Schondelmayer - Barry Co. LCRGR

Register of Deeds Stamp & File Number

4. Lot No. _____, Recorded Plat _____
5. Private Claims _____

I, Gary C. Bilow, in a field survey on January 28, 1998 do hereby state that under requirements of P.A. 74, Michigan P.A. of 1970, the corner points mentioned in lines 1 and 2 above were in conformance with regulations and rules therefore as required in the current manual of survey instructions of the United States Department of the Interior, Bureau of Land Management or by a decree of a Court of Law and/or that the corner points mentioned in lines 3, 4, and 5 above were in conformance with the rules of the Michigan Board of Land Surveyors or by a Decree of a Court of Law; established, re-established, monumented, recovered, found as expressed below:

NOTE: Not more than 2 corners, all in the same town and range, may be recorded on this certificate.

1	A	B	C	D	E	F	G	H	I	J	K	L
2		6		5		4		3		2		1
3												
4		7		8		9		10		11		12
5												
6		10		17		16		15		14		13
7												
8		19		20		21		22		23		24
9												
10		30		29		28		27		26		25
11												
12		31		32		33		34		35		36
13												

A. Description of original monument and accessories and/or subsequent restoration:

J3, Post set by US Deputy Surveyor S Sibley in January 1827, witnessed to a White Oak 8, N1°E, 92 links and a White Oak 8, S301/2° 53 links - half miles measured 40.01 chains (2640.66). In April 1867, County Surveyor AC Willson set a stake and brick and took new bearing, a Black Oak 10, S70°E, 49 1/2 links (Liber 2, page 146. Willson measured the half mile east 39.98 chains (2638.68). In May, 1867, Willson calls for a buried brick at the corner (Liber 2, page 162).


B. Description of corner evidence found and/or method applied in restoring or reestablishing corner:

J3, Found brick at intersection of old fences. Distance to fence east measures 1322.7. Distance to section corner east measures 2644. Accepted brick as best evidence of the location of the original corner.

ACT 345 BARRY COUNTY REMONUMENTATION
APPROVED BY PEER REVIEW AT A MEETING HELD ON
APRIL 14, 1997 BR
BRIAN REYNOLDS COUNTY SURVEYOR

C. Description of monument for corner and accessories established to perpetuate locating the position of the corner:

J3, Replaced brick with 1/2" x 36" rebar encased in a 4" concrete cylinder capped with a cast aluminum Michigan Department of Natural Resource tablet. Monument projects 6". Witnessed:
Set nail with MDNR tag W. Oak 30° N17° W 82.68'
Set nail with MDNR tag W. Ash 14° N 49° E 24.68'
Set nail with MDNR tag W. Oak 18° S 45° E 61.45'
Set nail with MDNR tag W. Oak 14° S 24° E 43.49'
Set nail with MDNR tag W. Oak 24° S 28° W 16.53'

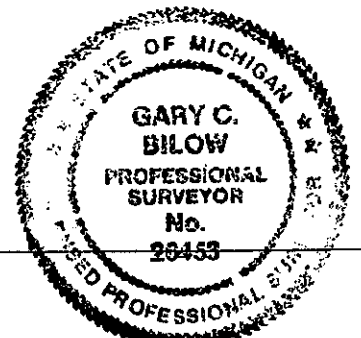

Signed by Gary C. Bilow
Surveyor's Michigan License No. 26453

Date December 30, 1998