


APR 04 2000

BARRY COUNTY REMONUMENTATION LAND CORNER RECORDATION CERTIFICATE Filing Requirement of Act 74, Mich. P.A. 1970

SECTION

For Corners in BARRY (county) Located in: Corner Code # 1. Public Land Survey SOUTH 1/4 CORNER SECTION 35 ORANGEVILLE TOWNSHIP ON TOWNSHIP LINE Located in: T 2N R 10W J-13 2. Property Controlling in Section S T R S T R 3. Miscellaneous S T R

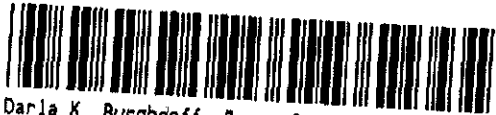

2820

Page: 1 of 1 12/07/1999 08:36A

Darla K. Burghdoff - Barry Co. LCRCR

Register of Deeds Stamp & File Number

4. Lot No. Recorded Plat 5. Private Claims

Grid with columns A-M and rows 1-13. Contains numbers 1-36 in a grid pattern.

I, Brian Reynolds, in a field survey on 22 NOVEMBER, 1999 do hereby certify that under requirements of P.A. 74, Michigan P.A. of 1970, the corner points mentioned in lines 1 and 2 above were in conformance with regulations and rules therefore as required in the current manual of survey instructions of the United States Department of the Interior, Bureau of Land Management or by a decree of a Court of Law and/or that the corner points mentioned in lines 3, 4, and 5 above were in conformance with the rules of the Michigan Board of Land Surveyors or by a Decree of a Court of Law; established, re-established, monumented, re-monumented, recovered, found as expressed below.

NOTE: Not more than 2 corners, all in the same town and range, may be recorded on this certificate.

- A. Description of original monument and accessories and/or subsequent restoration: 1. GENERAL LAND OFFICE: JOHN MULLETT, D.S., 1826 (R10W, P. 64) Y. OAK 10 N72E 20 Do. 10 N63W 25 2. (FOR CORRESPONDING CLOSING CORNER J-1 T2N R10W) COUNTY SURVEYOR RECORDS: JOHN Q. CRESSY, OCT. 7, 1884 (L.2, P. 242 RESURVEY) "PUT IN TILE, TOOK NEW BEARINGS" HICKORY 16 SOUTH 150 NO OTHER TIMBER NEAR 3. (FOR CORRESPONDING CLOSING CORNER J-1 T2N R10W) RECORDED PLATS: SUPERVISOR'S PLAT OF THE VILLAGE OF PRAIRIEVILLE, ROY.J. ROBB, P.S. #396, 14 MAY, 1931 (LIBER 2 OF PLATS, PAGE 74) REFERENCED, NO WITNESSES THE RECORDED PLAT DRAWING SHOWS THE EAST LINE OF THE "COUNTY HIGHWAY" (NORRIS ROAD, 66 FOOT R/W) IN LINE WITH J-1, BUT THE METES AND BOUNDS DESCRIPTION OF THE PLAT BOUNDARY IMPLIES THAT THE CORNER WOULD BE AT A 1*15' (AT THE NORTHWEST CORNER OF LOT 51) DEFLECTION FROM THE ROAD R/W LINE.

B. Description of corner evidence found and/or method applied in restoring or reestablishing corner: FOUND A RAILROAD SPIKE AT INTERSECTION OF ROADS, APPARENTLY REPRESENTING SUBJECT CORNER. DID NOT FIND ANY EVIDENCE OF PREVIOUS MONUMENTATION AT APPARENT CORRESPONDING CLOSING CORNER LOCATION. BASED ON EXPERIENCE WITH RETRACING OTHER PLATS AND SURVEYS BY R.J. ROBB, DISCOUNTED POSITION OF CORNER AS REPRESENTED ON THE PLAT. TRAVERSED TOWN LINE FROM G-13 TO M-13, TYING IN OCCUPATION LINES AND CORNER MONUMENTS. ANALYSIS OF RESULTING MEASUREMENTS CONFIRMED FOUND RAILROAD SPIKE AS J-13, T2N R10W. ACCEPTED FOUND RAILROAD SPIKE AS BEST AVAILABLE EVIDENCE OF CORNER POSITION. REPLACED RAILROAD SPIKE WITH STANDARD BARRY COUNTY REMONUMENTATION MONUMENT AND INSTALLED MONUMENT BOX.

C. Description of monument for corner and accessories established to perpetuate locating the position of the corner: SET STANDARD BARRY COUNTY REMONUMENTATION MONUMENT (3/4" X 36" IRON) WITH ALUMINUM CAP IN MONUMENT BOX. SET 20d NAIL W/REMON TAG IN THE NORTH SIDE OF A UTILITY POLE S70*W 84.04' SET 20d NAIL W/REMON TAG IN THE NORTH SIDE OF A UTILITY POLE S80*E 121.24' TOP CENTER OF A STEEL GUARD POST N13*W 85.84' TOP CENTER OF A STEEL GUARD POST N45*E 45.03' CORNER LIES 6*+/- WEST OF NORTH-SOUTH CENTERLINE CORNER LIES 2*+/- SOUTH OF EAST-WEST CENTERLINE J-1, T1N, R10W LIES EAST 36.55'

ACT 345 BARRY COUNTY REMONUMENTATION APPROVED BY PEER REVIEW AT A MEETING HELD ON

13 May '96 BRIAN REYNOLDS COUNTY SURVEYOR



Signed by [Signature] Surveyor's Michigan License No 31602

Date Dec 3, 1999