

APR 04 2000

Barry County Remonumentation Program
LAND CORNER RECORDATION CERTIFICATE
Filing Requirement of Act 74, Mich. P.A. 1970

SECTION
For corners in Orangeville Township Section Corner 1, 2, 11, 12

<u>Barry</u> (County)	Located in:	Corner Code #
1. Public Land Survey	T2N R10W	K3
	T _____ R _____	_____
	T _____ R _____	_____
	T _____ R _____	_____
2. Property Controlling in Section	S _____ T _____ R _____	_____
	S _____ T _____ R _____	_____
3. Miscellaneous Property in Sec.	S _____ T _____ R _____	_____
	S _____ T _____ R _____	_____



2759
Page: 1 of 1
01/27/1999 03:56


Sandy Schondeimayer - Barry Co. LCRCR

Register of Deeds Stamp & File Number

4. Lot No. _____, Recorded Plat _____
5. Private Claims _____

I, Gary C. Bilow, in a field survey on January 22, 1998 do hereby state that under requirements of P.A. 74, Michigan P.A. of 1970, the corner points mentioned in lines 1 and 2 above were in conformance with regulations and rules therefore as required in the current manual of survey instructions of the United States Department of the Interior, Bureau of Land Management or by a decree of a Court of Law and/or that the corner points mentioned in lines 3, 4, and 5 above were in conformance with the rules of the Michigan Board of Land Surveyors or by a Decree of a Court of Law; established, re-established, monumented, recovered, found as expressed below:

NOTE: Not more than 2 corners, all in the same town and range, may be recorded on this certificate.

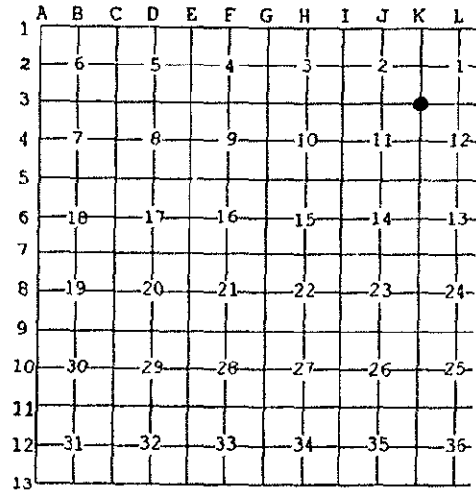

A. Description of original monument and accessories and/or subsequent restoration:

K3, Post established by U.S. Deputy Surveyor S Sibley in January 1827 - accessories a Y Oak 13, S 85-1/2 E, 67 links and Y Oak 20, I 60-1/2 W, 77 links. County Surveyor A.C. Willson recorded in an 1867 subdivision of Section 2 in Volume 2 Page 163 "Set Stake & Sto for SE Corner" but listed no witnesses. The County Road Commission records witnesses: Game Post, W 19.3; 30" Oak, W, 53.6 and 3 Oak, N 20E 42.2.

B. Description of corner evidence found and/or method applied in restoring or reestablishing corner:

K3, Established corner in McKibben Road at E-W fence at proportional distances from J3 and L3. Corner is 2640.92 west of L3, 2644.2 east of J3 and 2651.19 north of K4. Fence line west found 2620 north. Found stone tentatively identified as corner by others 49.5 north and 11.8 east of final position.

ACT 345 BARRY COUNTY REMONUMENTATION
APPROVED BY PEER REVIEW AT A MEETING HELD ON


APRIL 14, 1997 BR
BRIAN REYNOLDS COUNTY SURVEYOR

C. Description of monument for corner and accessories established to perpetuate locating the position of the corner:

K3, Set 24" iron bar with Barry County Remonumentation Program cap 8" deep

Witnesses:

- | | |
|---------------|---------------------------------------|
| S 70° E 21.21 | Spike & tag in N side 8"-14" quad Oak |
| S 25° W 61.09 | Spike & tag in SE side 10" Oak |
| N 83° W 14.24 | Spike & tag in NE side 12" Oak |
| N 30° E 53.99 | Spike & tag in E side 44" Oak |
- Corner is 5' +/- W of c/l gravel road.

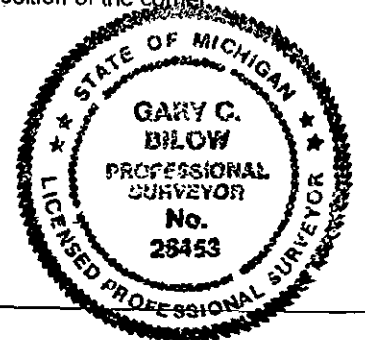

Signed by Gary C. Bilow
Surveyor's Michigan License No. 26453

Date December 30, 1998