

APR 08 1996

COMMISSION

BARRY COUNTY REMONUMENTATION
LAND CORNER RECORDATION CERTIFICATE
Filing Requirement of Act 74, Mich. P.A. 1970

STATE OF MICHIGAN
COUNTY OF BARRY
RECEIVED FOR RECORD

OCT 16 10 59 AM '95

Sandy Schondalmarer
REGISTER OF DEEDS

002303

Register of Deeds Stamp & File Number

For corners in

Barry (County)	Located In:	Corner Code #
1. Public Land Survey	T <u>2N</u> R <u>10W</u>	<u>L-3</u>
	T _____ R _____	_____
	T _____ R _____	_____
	T _____ R _____	_____
2. Property Controlling in Section	S _____ T _____ R _____	_____
	S _____ T _____ R _____	_____
3. Miscellaneous Property in Sec.	S _____ T _____ R _____	_____
	S _____ T _____ R _____	_____
4. Lot No. _____, Recorded Plat _____		
5. Private Claims _____		

	A	B	C	D	E	F	G	H	I	J	K	L	M
2	6	5	4	3	2	1							
3													
4	7	8	9	10	11	12							
5													
6	18	17	16	15	14	13							
7													
8	19	20	21	22	23	24							
9													
10	30	29	28	27	26	25							
11													
12	31	32	33	34	35	36							

ORANGEVILLE TOWNSHIP

I, William K. Crane, in a field survey on January 18, 19 95, do hereby certify that under requirements of P.A. 74, Michigan P.A. of 1970, the corner points mentioned in lines 1 and 2 above were in conformance with regulations and rules therefore as required in the current manual of survey instructions of the United States Department of the Interior, Bureau of Land Management or by a decree of a Court of Law and/or that the corner points mentioned in lines 3, 4 and 5 above were in conformance with the rules of the Michigan Board of Land Surveyors or by a Decree of a Court of Law; established, re-established, monumented, re-monumented, recovered, found as expressed below:

NOTE: Not more than 4 corners, all in the same town and range, may be recorded on this certificate.

A. Description of original monument and accessories and/or subsequent restoration:

Government Land Office: Sylvester Sibley D.S. 1827 (R. 10 W. P. 79)

West corrected	39.96		
A.W. Oak 10"	S 9° E	58 links	
A.Y. Oak 11"	S 55° W	9 links	

A.C. Willson April 16, 1867 found post by bearings and took new one
B. Oak 10" S 70° E, 49½ links
Cobb 1887 found stumps of government bearings and remnants of stake. Set stakes & stones.

B. Description of corner evidence found and/or method applied in restoring or reestablishing corner:

Found traces of fence North, East and West. Excavated at intersection of fences and found a circle of medium size stones with an oblong stone about 6" long and 4" at base narrowing to a point at the top in the center of the circle of stones. Held as original corner location as perpetuated by Willson and Cobb referred to above.


ACT 345 BARRY COUNTY REMONUMENTATION
APPROVED BY PEER REVIEW AT A MEETING HELD ON

9 OCT. '95 BR
BRIAN REYNOLDS COUNTY SURVEYOR

C. Description of monument for corner and accessories established to perpetuate locating the position of the corner:

Set Barry County Remonumentation Monument with aluminum cap.

Set nail w/cap	NE side	2" Hickory	N 27° W	17.36'
Set nail w/cap	South side	10" W. Oak	N 48° E	11.17'
Set nail w/cap	SE side	4" Hickory	S 54° E	4.93'
Set nail w/cap	NW side	6" R. Oak	S 46° W	27.48'

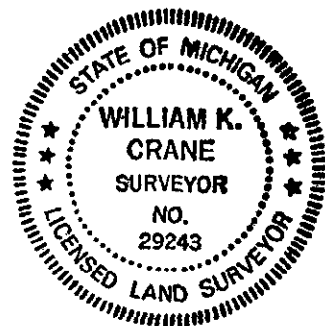

Signed by William K. Crane Date October 9, 1995
Surveyor's Michigan License No. 29243