

APR 04 2000

SECTION

Barry County Remonumentation Program
 LAND CORNER RECORDATION CERTIFICATE
 Filing Requirement of Act 74, Mich. P.A. 1970
 Quarter Corner 12, 13

For corners in Orangeville Township


Barry (County)	Located in:	Corner Code #
1. Public Land Survey	T2N R10W L5	
	T R	
	T R	
	T R	
2. Property Controlling in Section	S T R	
	S T R	
3. Miscellaneous Property in Sec.	S T R	
	S T R	

2762
 Page: 1 of 1
 01/27/1999 03:56
 Sandy Schondelmeyer - Barry Co. LCRCR

Register of Deeds Stamp & File Number

4. Lot No. _____, Recorded Plat _____
 5. Private Claims _____

I, Gary C. Bilow, in a field survey on January 22, 1998 do hereby state that under requirements of P.A. 74, Michigan P.A. of 1970, the corner points mentioned in lines 1 and 2 above were in conformance with regulations and rules therefore as required in the current manual of survey instructions of the United States Department of the Interior, Bureau of Land Management or by a decree of a Court of Law and/or that the corner points mentioned in lines 3, 4, and 5 above were in conformance with the rules of the Michigan Board of Land Surveyors or by a Decree of a Court of Law; established, re-established, monumented, recovered, found as expressed below:

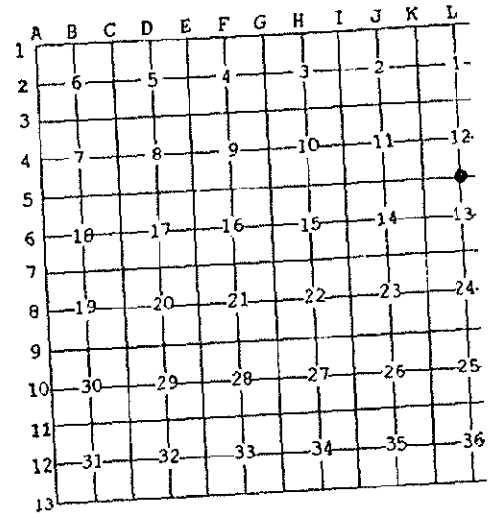

NOTE: Not more than 2 corners, all in the same town and range, may be recorded on this certificate.

A. Description of original monument and accessories and/or subsequent restoration:

L5, Post established U.S. Deputy Surveyor S Sibley in January 1827 - accessories a Y Oak 16, S 30 W, 28 links and a W Oak 9, N 30 37 links. County Surveyor A C Willson found the original post and US Bearings in April 1867 and added a witness to a B Oak 30, S 81 32-1/2 links.

B. Description of corner evidence found and/or method applied in restoring or reestablishing corner:

L5, Established corner at intersection of old fences east, west, and south. Measured 2638.02 west to K5 and 2643.45 east to M5.

ACT 345 BARRY COUNTY REMONUMENTATION
 APPROVED BY PEER REVIEW AT A MEETING HELD ON
 APRIL 14, 1997 BR
 BRIAN REYNOLDS COUNTY SURVEYOR

C. Description of monument for corner and accessories established to perpetuate locating the position of the corner:

L5, Set 36" bar with Barry County Remonumentation Program cap in wire loop at corner
 Witnessed:
 N 35° E 18.74 Spike & tag in W side 8" Oak
 East 20.48 Spike & tag in N side 26" W Oak
 S 45° E 8.25 Spike & tag in W side 28" Oak
 West 27.02 Spike & tag in N side 26" Oak



Signed by Gary C. Bilow
 Surveyor's Michigan License No. 26453

Date December 30, 1998