

APR 08 1996

COMMISSION

BARRY COUNTY REMONUMENTATION
LAND CORNER RECORDATION CERTIFICATE
Filing Requirement of Act 74, Mich. P.A. 1970

STATE OF MICHIGAN
COUNTY OF BARRY
RECEIVED FOR RECORD

OCT 16 10 59 AM '95

Sandy Schondelmar
REGISTER OF DEEDS

002301

Register of Deeds Stamp & File Number

For corners in

Barry
(County)

Located In:

Corner Code #

- 1. Public Land Survey T 2N R 10W M-2
T _____ R _____
T _____ R _____
T _____ R _____
- 2. Property Controlling S _____ T _____ R _____
in Section S _____ T _____ R _____
- 3. Miscellaneous S _____ T _____ R _____
Property in Sec. S _____ T _____ R _____
- 4. Lot No. _____, Recorded Plat _____
- 5. Private Claims _____

	A	B	C	D	E	F	G	H	I	J	K	L	M
2	6	5	4	3	2	1							
3													
4	7	8	9	10	11	12							
5													
6	18	17	16	15	14	13							
7													
8	19	20	21	22	23	24							
9													
10	30	29	28	27	26	25							
11													
12	31	32	33	34	35	36							
13													

ORANGEVILLE TOWNSHIP

I, William K. Crane, in a field survey on January 18, 19 95, do hereby certify that under requirements of P.A. 74, Michigan P.A. of 1970, the corner points mentioned in lines 1 and 2 above were in conformance with regulations and rules therefore as required in the current manual of survey instructions of the United States Department of the Interior, Bureau of Land Management or by a decree of a Court of Law and/or that the corner points mentioned in lines 3, 4 and 5 above were in conformance with the rules of the Michigan Board of Land Surveyors or by a Decree of a Court of Law, established, re-established, monumented, re-monumented, recovered, found as expressed below:

NOTE: Not more than 4 corners, all in the same town and range, may be recorded on this certificate.

A. Description of original monument and accessories and/or subsequent restoration:

General Land Office: John Mullett D.S. 1826 (R. 10W. P. 69)
W. Oak 14" N 45 W 43 Links
D.O. 7" 56 W 56 Links

No other recorded historical information available on this corner.

B. Description of corner evidence found and/or method applied in restoring or reestablishing corner:

Excavated extensively at prorated corner location found nothing. Set corner at proportional distance.


ACT 345 BARRY COUNTY REMONUMENTATION
APPROVED BY PEER REVIEW AT A MEETING HELD ON

9 Oct. '95 BR
BRIAN REYNOLDS COUNTY SURVEYOR

C. Description of monument for corner and accessories established to perpetuate locating the position of the corner:

Set Barry County Remonumentation Monument with aluminum cap.

Set nail w/cap North side 12" Oak N 76° W 40.98'
Set nail w/cap East side 6" Cherry N 21° W 24.05'
Set nail w/cap East side 14" Oak North 49.82'
Set nail w/cap West side 4" Hickory N 22° E 57.43'

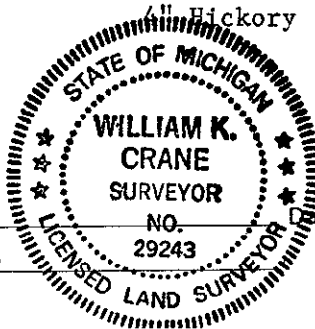

Signed by William K. Crane
Surveyor's Michigan License No. 29243

Date October 9, 1995