

APR 08 1996

COMMISSION

BARRY COUNTY REMONUMENTATION  
LAND CORNER RECORDATION CERTIFICATE

Filing Requirement of Act 74, Mich. P.A. 1970

STATE OF MICHIGAN  
COUNTY OF BARRY  
RECEIVED FOR RECORD

OCT 16 10 59 AM '95

Sandy Schindelmarper

REGISTER OF DEEDS

002300

Register of Deeds Stamp & File Number

For corners in

Barry (County)	Located in:	Corner Code #
1. Public Land Survey	T 2N R 10W	M-3
	T _____ R _____	_____
	T _____ R _____	_____
	T _____ R _____	_____
2. Property Controlling in Section	S _____ T _____ R _____	_____
	S _____ T _____ R _____	_____
3. Miscellaneous Property in Sec.	S _____ T _____ R _____	_____
	S _____ T _____ R _____	_____
4. Lot No. _____, Recorded Plat _____		
5. Private Claims _____		

I, William K. Crane, in a field survey on January 18, 19 95, do hereby certify that under requirements of P.A. 74, Michigan P.A. of 1970, the corner points mentioned in lines 1 and 2 above were in conformance with regulations and rules therefore as required in the current manual of survey instructions of the United States Department of the Interior, Bureau of Land Management or by a decree of a Court of Law and/or that the corner points mentioned in lines 3, 4 and 5 above were in conformance with the rules of the Michigan Board of Land Surveyors or by a Decree of a Court of Law; established, re-established, monumented, re-monumented, recovered, found as expressed below:

**NOTE: Not more than 4 corners, all in the same town and range, may be recorded on this certificate.**

A. Description of original monument and accessories and/or subsequent restoration:  
 General Land Office: John Mullett D.S. 1826 (R. 10W. P.69)

W. Oak 8"	N 73 W	71 Links
DO 8"	S 34 W	94 Links


No other historical information available on this corner.

B. Description of corner evidence found and/or method applied in restoring or reestablishing corner:  
 Excavated 62 links North of Southwest corner of Section 6, T.2 N. R. 9 W. Hope Township and found nothing. Set corner at government distance (40.92') North on Township line from the aforementioned Southwest corner.

ACT 345 BARRY COUNTY REMONUMENTATION  
 APPROVED BY PEER REVIEW AT A MEETING HELD ON  
9 Oct. '95 BR  
 BRIAN REYNOLDS COUNTY SURVEYOR


C. Description of monument for corner and accessories established to perpetuate locating the position of the corner:  
 Set Barry County Remonumentation Monument with aluminum cap.

Set nail w/cap	Northeast side	6" Oak	N 35° W	26.54'
Set nail w/cap	East side	U. Pole	N 2° W	87.92'
Set nail w/cap	East side	U. Pole	N 24° E	76.47'
Set nail w/cap	North side	6" Cherry	S 88° E	57.50'

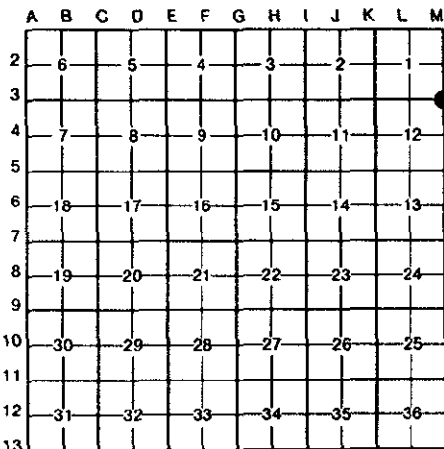

ORANGEVILLE TOWNSHIP

Signed by William K. Crane  
 William K. Crane  
 Surveyor's Michigan License No. \_\_\_\_\_

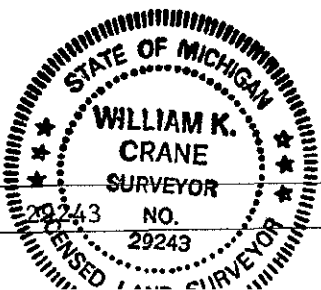

Date October 9, 1995