

MAY 29 1997

BARRY COUNTY REMONUMENTATION
LAND CORNER RECORDATION CERTIFICATE
Filing Requirement of Act 74, Mich. P.A. 1970

STATE OF MICHIGAN
COUNTY OF BARRY
RECEIVED

DEC 9 2 10 PM '96

Sandy Schmitz-Mayer
REGISTER OF DEEDS

002441

Register of Deeds Stamp & File Number

For corners in

<u>BARRY</u> (County)	Located In:	Corner Code #
1. Public Land Survey	T <u>2</u> R <u>10</u>	<u>M-12</u>
1/4 CORNER COMMON TO	T ___ R ___	_____
SEC. 36	T ___ R ___	_____
ORANGEVILLE TWP.	T ___ R ___	_____
2. Property Controlling	S ___ T ___ R ___	_____
in Section	S ___ T ___ R ___	_____
3. Miscellaneous	S ___ T ___ R ___	_____
Property in Sec.	S ___ T ___ R ___	_____

4. Lot No. _____, Recorded Plat _____
5. Private Claims _____

I, RAYMOND MOORED in a field survey on MAY, 1995 do hereby state that under requirements of P.A. 74, Michigan P.A. of 1970, the corner points mentioned in lines 1 and 2 above were in conformance with regulations and rules therefore as required in the current manual of survey instructions of the United States Department of the Interior, Bureau of Land Management or by a decree of a Court of Law and /or that the corner points mentioned in lines 3, 4 and 5 above were in conformance with the rules of the Michigan Board of Land Surveyors or by a Decree of a Court of Law; established, re-established, monumented, recovered, found as expressed below:

NOTE: Not more than 2 corners, all in the same town and range, may be recorded on this certificate.

A	B	C	D	E	F	G	H	I	J	K	L	M
1												
2	6		5		4		3		2		1	
3												
4	7		8		9		10		11		12	
5												
6	18		17		16		15		14		13	
7												
8	19		20		21		22		23		24	
9												
10	30		29		28		27		26		25	
11												
12	31		32		33		34		35		36	
13												

A. Description of original monument and accessories and/or subsequent restoration:

G.L.O. JOHN MULLETT D.S. 1826 (R10W, P.66) W. OAK 14 S. 38 W. 65.W. ASH 10 N.50 1/2 W. 42. BOWEN 1876 (L.1, P.163) IRON, BRICK AND CROCKERY HICKORY 5 S. 56 1/4 E. 37. BATEMAN 3,4 AUGUST 1900 (L.1, P.352) & (L.3, P.38) STAKE HICKORY 9 S 56 1/4 E 24 FT. COBB NOV. 11, 1912 (BROWN HOPE TWP. F.B., P.15 BEYOND GLO TRANS.) SET IRON ROD 1" X 4' IN PIT OF STONE & BRK. FOUND STUMP OF TREE BY BOWEN HICKORY 16 N. 26 1/2 E. 97 1/2 LKS. 12 N 21 3/4 W. 123 LKS. IRON 6" HICKORY N60DEG.W. 26.0' 8" HICKORY N40DEG.W. 38.5' 6" HICKORY S.35DEG E. 46.5'

B. Description of corner evidence found and/or method applied in restoring or reestablishing corner:


FD 1/2" IRON PER ABOVE INFO. EXCAVATED AROUND IRON. FD NO STONES OR BRICK. IRON FOUND MATCHED OLD FENCE TO WEST. DETERMINED IT TO BE E 1/4 POST SEC. 36 SET REMON IRON W/CAP.

ACT 345 BARRY COUNTY REMONUMENTATION
APPROVED BY PEER REVIEW AT A MEETING HELD ON

10 April '95 BR
BRIAN REYNOLDS COUNTY SURVEYOR

C. Description of monument for corner and accessories established to perpetuate locating the position of the corner:

SET BARRY COUNTY REMON IRON W/CAP
-PK & TAG S. SIDE P. POLE WEST 13.87'
-PK & TAG NE SIDE 8" HICK S. 3DEG. E. 33.94'
-PK & TAG SW SIDE 8" HICK S 40DEG. E. 33.06'
-PK & TAG NW SIDE 28" R. OAK N45DEG. E. 65.84'

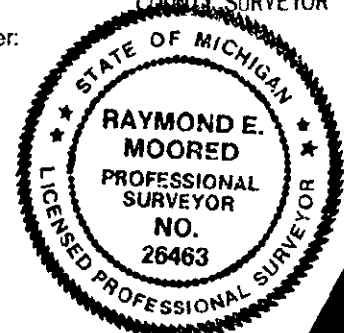

Signed by Raymond Moored
Surveyor's Michigan License No. 26463

Date 11/4/96