

1993

COMMISSION

BARRY COUNTY REMONUMENTATION LAND CORNER RECORDATION CERTIFICATE Filing Requirement of Act 74, Mich. P.A. 1970

STATE OF MICHIGAN COUNTY OF BARRY RECEIVED FOR RECORD

JUL 20 11 20 AM '93

Sandy Schondelmayer REGISTER OF DEEDS

002027

Register of Deeds Stamp & File Number

For corners in

Table with columns: BARRY (County), Located In, Corner Code #. Includes entries for Public Land Survey, Property Controlling, and Miscellaneous.

4. Lot No. _____, Recorded Plat _____
5. Private Claims _____

I, BRIAN REYNOLDS, in a field survey on JULY, 1993, do hereby certify that under requirements of P.A. 74, Michigan P.A. of 1970, the corner points mentioned in lines 1 and 2 above were in conformance with regulations and rules therefore as required in the current manual of survey instructions of the United States Department of the Interior, Bureau of Land Management or by a decree of a Court of Law and/or that the corner points mentioned in lines 3, 4 and 5 above were in conformance with the rules of the Michigan Board of Land Surveyors or by a Decree of a Court of Law; established, re-established, monumented, re-monumented, recovered, found as expressed below:

NOTE: Not more than 4 corners, all in the same town and range, may be recorded on this certificate.

A. Description of original monument and accessories and/or subsequent restoration: TOWNSHIP CORNER ESTABLISHED IN JANUARY, 1826 BY GENERAL LAND OFFICE DEPUTY SURVEYOR JOHN MULLETT. W. OAK 9 S23W 21 DO 8 S75E 90


CRESSY (1884) PRAIRIEVILLE RESURVEY FOUND OLD CORNER. TOOK NEW BEARINGS PUT IN TILE 3 FEET DEEP. HICKORY 8 S4W 38 1/2 W. O. 24 S75E 90 (L. 2, P. 242) PRATT (L. 1, P. 333) SURVEY OF SEC. 6, T1N, R9W SEPTEMBER 6, 1888 W. O. 8 S75E 90 U.S.B.T. ALIVE MADE NEW HICK 8 S2°W .38 ADDITIONAL HISTORICAL INFORMATION ON BACK OF FORM

B. Description of corner evidence found and/or method applied in restoring or reestablishing corner: FOUND CAPPED IRON (#12447 "IWM") IN 3" HOLLOW CLAY TILE AS PER L.C.R.C. #114. ALL WITNESSES FROM L.C.R.C. PRESENT AND CHECKED. ALSO FOUND WITNESS NAIL IN 12" MAPLE S8°E 12.15'

ACCEPTED AS A CAREFUL AND FAITHFUL PERPETUATION OF THE POSITION OF THE CORNER AS PREVIOUSLY CAREFULLY AND FAITHFULLY PERPETUATED BY CRESSY (1884).

C. Description of monument for corner and accessories established to perpetuate locating the position of the corner:

SET STANDARD 3/4" REMONUMENTATION IRON AND ALUMINUM CAP IN 3" CLAY TILE P.K. NAIL AND WITNESS TAG IN 24" HICKORY S4°W 25.49' P.K. NAIL AND WITNESS TAG IN 12" HICKORY S76°W 27.26' P.K. NAIL AND WITNESS TAG IN 12" CHERRY N46°W 19.02' P.K. NAIL AND WITNESS TAG IN 12" CHERRY N67°E 16.13' FENCES SOUTH, EAST AND WEST

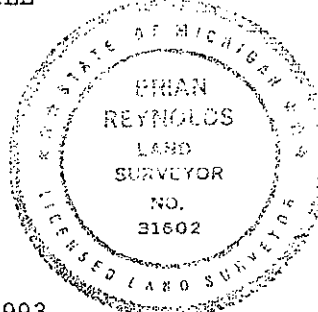

Signed by [Signature]

Date JULY 15, 1993

Surveyor's Michigan License No. 31602

PART "A" (CONTINUED)

*BATEMAN (L. 3, P. 38) SURVEY OF SECTION 36, T2N, R10W
AUGUST 17, 1900 TILE (NO WITNESSES)

L.C.R.C. #114 LARRY G. WATSON R.L.S. #12447 FEBRUARY 27, 1973
FOUND TILE

12"	MAP.	NORTH	22.23'
15"	OAK	WEST	30.43'
12"	MAP.	EAST	35.00'