

SURVEY & REMONUMENTATION

1993

COMMISSION

For corners in

BARRY
(County)

**BARRY COUNTY REMONUMENTATION
LAND CORNER RECORDATION CERTIFICATE**
Filing Requirement of Act 74, Mich. P.A. 1970

STATE OF MICHIGAN
COUNTY OF BARRY
RECEIVED FOR RECORD

JUL 20 11 20 AM '93

Sandy Schondelmar
REGISTER OF DEEDS

002040

Register of Deeds Stamp & File Number

	Located In:	Corner Code #
1. Public Land Survey	T <u>3N</u> R <u>7W</u>	<u>C-4</u>
	T _____ R _____	<u>CASTLETON TWNSP.</u>
	T _____ R _____	<u>1/4 COR. SEC. 7 & 8</u>
	T _____ R _____	_____
2. Property Controlling in Section	S _____ T _____ R _____	_____
	S _____ T _____ R _____	_____
3. Miscellaneous Property in Sec.	S _____ T _____ R _____	_____
	S _____ T _____ R _____	_____
4. Lot No. _____, Recorded Plat _____		
5. Private Claims _____		

A	B	C	D	E	F	G	H	I	J	K	L
2	6	5	4	3	2	1					
3											
4	7	8	9	10	11	12					
5											
6	18	17	16	15	14	13					
7											
8	19	20	21	22	23	24					
9											
10	30	29	28	27	26	25					
11											
12	31	32	33	34	35	36					
13											


I, **BRIAN REYNOLDS**, in a field survey on **23 & 24 APR**, 19**93**, do hereby certify that under requirements of P.A. 74, Michigan P.A. of 1970, the corner points mentioned in lines 1 and 2 above were in conformance with regulations and rules therefore as required in the current manual of survey instructions of the United States Department of the Interior, Bureau of Land Management or by a decree of a Court of Law and/or that the corner points mentioned in lines 3, 4 and 5 above were in conformance with the rules of the Michigan Board of Land Surveyors or by a Decree of a Court of Law; established, re-established, monumented, re-monumented, recovered, found as expressed below:

NOTE: Not more than 4 corners, all in the same town and range, may be recorded on this certificate.

A. Description of original monument and accessories and/or subsequent restoration:
G.L.O. : COUNTY SURVEYOR (NO NAME, NO DATE)
SUGAR 9" DIA. ELM 6 S39 1/2E 69 1/2
" 5 N38 1/4E 55 1/3

B. Description of corner evidence found and/or method applied in restoring or reestablishing corner:
FOUND 6" x 8" x 14" STONE W/CHISELED "V" & PLOW POINTS:
IN LINE WITH FENCE E. & W.

C. Description of monument for corner and accessories established to perpetuate locating the position of the corner:
SET BARRY Co. REMON. MONUMENT 0.5' BELOW GRADE:
C/L MARTIN RD. N-S
NW. FACE - 12" BLACK WALNUT - N43E - 52.58'
IRON "I" BEAM FENCE CORNER - DUE E. - 34.15'
W. FACE - W. TRUNK - TRIPLE PIGNUT HICKORY - S20E - 78.71'
NW. FACE - 7" BLACK WALNUT - S48W - 36.58'
NE. FACE - 16" BLACK WALNUT - N18W - 59.63'
EASTERLY FENCE & TREE ROW - DUE EAST

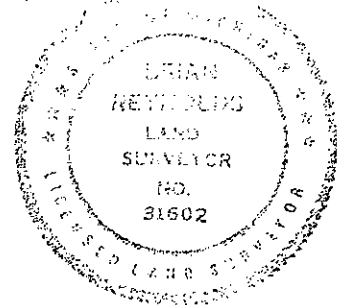

Signed by Brian Reynolds

Date 7-13-93

Surveyor's Michigan License No. 31602