

SURVEY & REMONUMENTATION

JUL 24 1997

COMMISSION

BARRY COUNTY REMONUMENTATION

LAND CORNER RECORDATION CERTIFICATE
Filing Requirement of Act 74, Mich. P.A. 1970

For Corners in <u>BARRY</u> (county)	Located In:	Corner Code #
1. Public Land Survey 1/4 CORNER COMMON TO SECTIONS 29 & 32 CASTLETON TOWNSHIP	T <u>3N</u> R <u>7W</u> T _____ R _____ T _____ R _____ T _____ R _____	<u>D-11</u> _____ _____ _____
2. Property Controlling in Section	S _____ T _____ R _____ S _____ T _____ R _____	_____ _____
3. Miscellaneous Property in Sec.	S _____ T _____ R _____ S _____ T _____ R _____	_____ _____
4. Lot No _____, Recorded Plat _____		
5. Private Claims _____		

STATE OF MICHIGAN
BARRY COUNTY
RECORDED

17 JUN 97 12:20 P.M.

SANDY SCHONDELMAYER
REGISTER OF DEEDS

002503

Register of Deeds Stamp & File Number

I, **Brian Reynolds**, in a field survey on **6 AUGUST, 1996** do hereby certify that under requirements of P.A. 74, Michigan P.A. of 1970, the corner points mentioned in lines 1 and 2 above were in conformance with regulations and rules therefore as required in the current manual of survey instructions of the United States Department of the Interior, Bureau of Land Management or by a decree of a Court of Law and/or that the corner points mentioned in lines 3, 4, and 5 above were in conformance with the rules of the Michigan Board of Land Surveyors or by a Decree of a Court of Law; established, re-established, monumented, re-monumented, recovered, found as expressed below.

A	B	C	D	E	F	G	H	I	J	K	L	M
2	6	5	4	3	2	1						
3												
4	7	8	9	10	11	12						
5												
6	18	17	16	15	14	13						
7												
8	19	20	21	22	23	24						
9												
10	30	29	28	27	26	25						
11												
12	31	32	33	34	35	36						
13												

NOTE: Not more than 2 corners, all in the same town and range, may be recorded on this certificate.

A. Description of original monument and accessories and/or subsequent restoration:

**GENERAL LAND OFFICE: SYLVESTER SIBLEY, D.S., 1830 (R7W,P.113) WEST CORRECTED 40.15
A BEECH 9 S44E 25 Do. 7 N73W 11**

***** NO OTHER RECORDED HISTORICAL INFORMATION AVAILABLE FOR THIS CORNER *****

B. Description of corner evidence found and/or method applied in restoring or reestablishing corner:

**FOUND NO EVIDENCE OF ORIGINAL CORNER MONUMENTATION. TRAVERSED ALL OF SECTIONS 29 & 32 TYING IN OCCUPATION.
SET STANDARD BARRY COUNTY REMONUMENTATION MONUMENT ON CENTERLINE AND IN LINE WITH FENCE/TREE LINES RUNNING NORTH AND SOUTH. THIS METHOD FITS VERY WELL WITH CORRESPONDING CORNERS AND OCCUPATION THROUGHOUT BOTH SECTIONS.**


C. Description of monument for corner and accessories established to perpetuate locating the position of the corner:

**SET STANDARD BARRY COUNTY REMONUMENTATION MONUMENT (WITH ALUMINUM CAP)
SET 20d NAIL W/REMON TAG IN THE EAST SIDE OF A 6" MAPLE N9°W 12.77'
SET 20d NAIL W/REMON TAG IN THE EAST SIDE OF A 14" BLACK WALNUT N18°E 13.68'
SET 20d NAIL W/REMON TAG IN THE EAST SIDE OF A 6" MAPLE S3°E 20.86'
SET 20d NAIL W/REMON TAG IN THE WEST SIDE OF A 4" MAPLE S39°W 20.66'
SET 20d NAIL W/REMON TAG IN THE SOUTH SIDE OF AN 8" BLACK WALNUT N72°W 44.42'
SET 20d NAIL W/REMON TAG IN THE EAST SIDE OF A 14" TWIN BLACK WALNUT N55°W 39.74'
1/2" CAPPED IRON S0°15'14"E 33.00' 1/2" CAPPED IRON N0°15'14"W 33.00'
IN LINE WITH DECAYING FENCE/TREE ROWS NORTH-SOUTH
ON CENTERLINE EAST-WEST GRAVEL/TRAIL ROAD (GREGG'S CROSSING)**

ACT 345 BARRY COUNTY REMONUMENTATION
APPROVED BY PEER REVIEW AT A MEETING HELD ON

3-11-96
BRIAN REYNOLDS

B.R.
COUNTY SURVEYOR

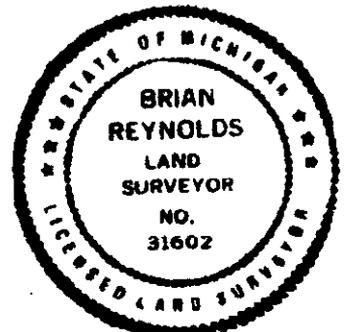

Signed by Brian Reynolds
Surveyor's Michigan License No. 31602

Date May 16, 1997