

STATE OF MICHIGAN
REMONUMENTATION

MAY 20 1997

COMMISSION

BARRY COUNTY REMONUMENTATION

LAND CORNER RECORDATION CERTIFICATE
Filing Requirement of Act 74, Mich. P.A. 1970

STATE OF MICHIGAN
COUNTY OF BARRY
RECEIVED

Dec 9 2 09 PM '96

Sandy Selandmeyer
REGISTER OF DEEDS

002431

Register of Deeds Stamp & File Number


For corners in

<u>BARRY</u> (County)	Located In:	Corner Code #
1. Public Land Survey	T <u>3</u> R <u>7W</u>	<u>E-3</u>
1/4 COR COMMON TO SEC'S 4, 5, 8, & 9 CASTLETON TWP.	T <u> </u> R <u> </u>	<u> </u>
2. Property Controlling in Section	T <u> </u> R <u> </u>	<u> </u>
3. Miscellaneous Property in Sec.	S <u> </u> T <u> </u> R <u> </u>	<u> </u>
	S <u> </u> T <u> </u> R <u> </u>	<u> </u>
	S <u> </u> T <u> </u> R <u> </u>	<u> </u>
	S <u> </u> T <u> </u> R <u> </u>	<u> </u>

4. Lot No. _____, Recorded Plat _____
5. Private Claims _____

I, RAMOND MOORED, in a field survey on SEPT, 1995 do hereby state that under requirements of P.A. 74, Michigan P.A. of 1970, the corner points mentioned in lines 1 and 2 above were in conformance with regulations and rules therefore as required in the current manual of survey instructions of the United States Department of the Interior, Bureau of Land Management or by a decree of a Court of Law and for that the corner points mentioned in lines 3, 4 and 5 above were in conformance with the rules of the Michigan Board of Land Surveyors or by a Decree of a Court of Law, established, re-established, monumented, recovered, found as expressed below:

NOTE: Not more than 2 corners, all in the same town and range, may be recorded on this certificate.

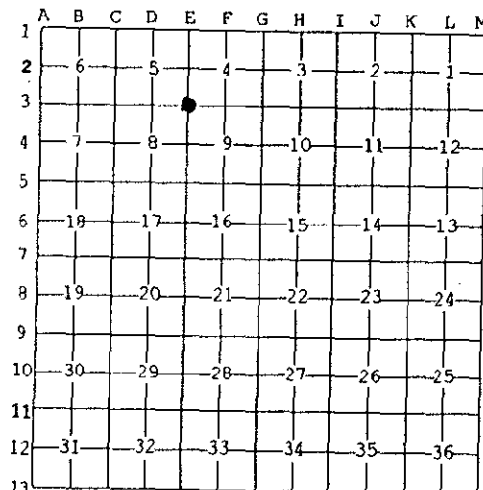

A. Description of original monument and accessories and/or subsequent restoration:

G.L.O. SYLVESTER SIBLEY D.S. 1830 (R7W, P.112) A. B. ASH 30 INCHES DIAMR. CORNER. COUNTY SURVEYOR BEARINGS FOUND A.D. RORK JUNE 20TH, 1866 (L.2, P.105) FOUND BY RUNNING CROP LINES TO 1/4 POST - STAKE & STONES & A KNOT MANE GEO B. MANCHESTER 29-30-31 APRIL 1885 (L.2, P.240)

B. Description of corner evidence found and/or method applied in restoring or reestablishing corner:

FOUND NO EVIDENCE OF CORNER LOCATION. ESTABLISHED CORNER IN CENTERLINE OF ROAD AT SECTION LINE OCCUPATION EAST AND WEST. ACCEPTED AS BEST AVAILABLE EVIDENCE OF CORNER LOCATION. SET STANDARD BARRY COUNTY REMONUMENTATION IRON WITH CAP.

ACT 345 BARRY COUNTY REMONUMENTATION
APPROVED BY PEER REVIEW AT A MEETING HELD ON

13 NOV. 95

BRIAN REYNOLDS

COUNTY SURVEYOR

C. Description of monument for corner and accessories established to perpetuate locating the position of the corner:

SET STANDARD BARRY COUNTY REMONUMENTATION IRON WITH CAP.
-NAIL & TAG IN W SIDE POWER POLE S30°E 102.41'
-NAIL & TAG IN S SIDE 7" HICKORY N80°W 53.84'
-NAIL & TAG IN E SIDE 10" HICKORY N65°W 47.58'
-NAIL & TAG IN E SIDE 6" POPLAR S40°W 56.30'
-IN CENTERLINE OF ROAD



Signed by

Raymond Moored

Date 11/4/96

Surveyor's Michigan License No. 26463