

BARRY COUNTY REMONUMENTATION

JUL 24 1997

LAND CORNER RECORDATION CERTIFICATE
Filing Requirement of Act 74, Mich. P.A. 1970

COMMISSION

For Corners in <u>BARRY</u> (county)	Located In:	Corner Code #
1. Public Land Survey 1/4 CORNER COMMON SECTIONS 28 & 29 CASTLETON TOWNSHIP	T <u>3N</u> R <u>7W</u> T _____ R _____ T _____ R _____ T _____ R _____	<u>E-10</u> _____ _____ _____
2. Property Controlling in Section	S _____ T _____ R _____ S _____ T _____ R _____	_____ _____
3. Miscellaneous Property in Sec.	S _____ T _____ R _____ S _____ T _____ R _____	_____ _____
4. Lot No _____, Recorded Plat _____		
5. Private Claims _____		

STATE OF MICHIGAN
BARRY COUNTY
RECORDED

17 JUN 97 12:19 P.M.

SANDY SCHONDELMAYER
REGISTER OF DEEDS

002500

Register of Deeds Stamp & File Number

I, **Brian Reynolds**, in a field survey on **6 AUGUST, 1996** do hereby certify that under requirements of P.A. 74, Michigan P.A. of 1970, the corner points mentioned in lines 1 and 2 above were in conformance with regulations and rules therefore as required in the current manual of survey instructions of the United States Department of the Interior, Bureau of Land Management or by a decree of a Court of Law and/or that the corner points mentioned in lines 3, 4, and 5 above were in conformance with the rules of the Michigan Board of Land Surveyors or by a Decree of a Court of Law; established, re-established, monumented, re-monumented, recovered, found as expressed below.

NOTE: Not more than 2 corners, all in the same town and range, may be recorded on this certificate.

A	B	C	D	E	F	G	H	I	J	K	L	M
2	6	5	4	3	2	1						
3												
4	7	8	9	10	11	12						
5												
6	18	17	16	15	14	13						
7												
8	19	20	21	22	23	24						
9												
10	30	29	28	27	26	25						
11												
12	31	32	33	34	35	36						
13												

A. Description of original monument and accessories and/or subsequent restoration:

- GENERAL LAND OFFICE: SYLVESTER SIBLEY, D.S., 1830 (R7W,P.109) AND ELM 30 S50W 4 A BEECH 10 N67E 26
- COUNTY SURVEYOR RECORDS: LEE S.COBB, 1894,(BR. CAS. FB,P.68 & TAN CAS. F.B.,P.8)
"FOUND LOG & STUMP OF ELM- OLD STAKE & STONE & BRICK" SET STONE 28 x 12 x 10 BRICK & TILE

*** NO OTHER RECORDED HISTORICAL INFORMATION AVAILABLE FOR THIS CORNER ***

B. Description of corner evidence found and/or method applied in restoring or reestablishing corner:

FOUND NO EVIDENCE OF CORNER MONUMENTATION. CORNER LIES IN A 7'+ FILL AREA OVER MARSH. REQUESTED ASSISTANCE FROM ROAD COMMISSION TO EXCAVATE BELOW ROAD GRADE FOR STONE BY COBB, WAS TOLD THAT THE ROAD COMMISSION HAS SPENT MANY YEARS AND MANY DOLLARS STABILIZING ROAD ABOVE OLD CORDUROY ROAD ACROSS MARSH. DETERMINED IT WAS NOT FEASIBLE TO EXCAVATE FOR STONE. HELD CENTERLINE OF ROAD AND FENCES EAST AND WEST AS BEST AVAILABLE EVIDENCE OF CORNER POSITION.
SET STANDARD BARRY COUNTY REMONUMENTATION MONUMENT.

C. Description of monument for corner and accessories established to perpetuate locating the position of the corner:


SET STANDARD BARRY COUNTY REMONUMENTATION MONUMENT (WITH ALUMINUM CAP)
SET 20d NAIL W/REMON TAG IN THE SOUTH SIDE OF A 10" WALNUT N89°E 35.06'
SET 20d NAIL W/REMON TAG IN THE SOUTH SIDE OF A 6" MAPLE CLUSTER N68°E 37.43'
SET "PK" W/REMON TAG IN THE SOUTH SIDE OF A UTILITY POLE S89°W 41.16'
CORNER LIES ON CENTERLINE OF NORTH-SOUTH BITUMINOUS ROADWAY
IN LINE WITH FENCES EAST AND WEST

ACT 345 BARRY COUNTY REMONUMENTATION
APPROVED BY PEER REVIEW AT A MEETING HELD ON

3-11-96

BRIAN REYNOLDS

BR
COUNTY SURVEYOR

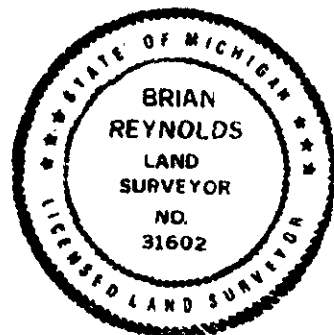

Signed by

Brian Reynolds

Surveyor's Michigan License No

31602

Date

MAY 16, 1997