

MAY 20 1997

COMMISSION

BARRY COUNTY REMONUMENTATION
LAND CORNER RECORDATION CERTIFICATE
Filing Requirement of Act 74, Mich. P.A. 1970

STATE OF MICHIGAN
COUNTY OF BARRY
REC'D

DEC 9 2 09 PM '96

Sandy Schenckmayer
REGISTER OF DEEDS

For corners in

<u>BARRY</u> (County)	Located In:	Corner Code #
1. Public Land Survey	T <u>3</u> R <u>7W</u>	<u>F-1</u>
1/4 COR COMMON TO SEC'S 4 CASTLETON TWP.	T <u> </u> R <u> </u>	<u> </u>
2. Property Controlling in Section	T <u> </u> R <u> </u>	<u> </u>
3. Miscellaneous Property in Sec.	S <u> </u> T <u> </u> R <u> </u>	<u> </u>
	S <u> </u> T <u> </u> R <u> </u>	<u> </u>

002426

Register of Deeds Stamp & File Number

4. Lot No. _____, Recorded Plat _____
5. Private Claims _____

I, RAYMOND MOORED, in a field survey on SEPT, 1995 do hereby state that under requirements of P.A. 74, Michigan P.A. of 1970, the corner points mentioned in lines 1 and 2 above were in conformance with regulations and rules therefore as required in the current manual of survey instructions of the United States Department of the Interior, Bureau of Land Management or by a decree of a Court of Law and /or that the corner points mentioned in lines 3, 4 and 5 above were in conformance with the rules of the Michigan Board of Land Surveyors or by a Decree of a Court of Law; established, re-established, monumented, recovered, found as expressed below:

NOTE: Not more than 2 corners, all in the same town and range, may be recorded on this certificate.

	A	B	C	D	E	F	G	H	I	J	K	L	M
1													
2	6			5		4		3		2		1	
3													
4	7			8		9		10		11		12	
5													
6	18			17		16		15		14		13	
7													
8	19			20		21		22		23		24	
9													
10	30			29		28		27		26		25	
11													
12	31			32		33		34		35		36	
13													

A. Description of original monument and accessories and/or subsequent restoration:

COUNTY SURVEYOR RECORDS SET POST A.D. RORK JUNE 20, 1866 (L. 2, P. 105) (M-43 #440 F.B, P. 1 NO DATE) STONE 20" ASH S60°W 71.1' CORNER IRON POST N 45DEG E 68.1' NE. CORNER OF HOUSE 90.5. SET IRON ON STONE PLACE MONU. BOX 1-26-73.


B. Description of corner evidence found and/or method applied in restoring or reestablishing corner:

FOUND NO EVIDENCE OF CORNER LOCATION. ESTABLISHED CORNER IN CENTERLINE OF ROAD AT THE AVERAGE OF GLO JOGS AT NW & NE CORNERS, ON LINE BETWEEN F-12 & F13 OF WOODLAND TWP. ACCEPTED AS BEST AVAILABLE EVIDENCE OF CORNER LOCATION. SET STANDARD BARRY COUNTY REMONUMENTATION IRON WITH CAP.

ACT 345 BARRY COUNTY REMONUMENTATION
APPROVED BY PEER REVIEW AT A MEETING HELD ON
13 NOV 95
BRIAN REYNOLDS COUNTY SURVEYOR

C. Description of monument for corner and accessories established to perpetuate locating the position of the corner:

- SET STANDARD BARRY COUNTY REMONUMENTATION IRON WITH CAP.
- NAIL & TAG IN N SIDE 28" ASH S65°W 87.68'
- NAIL & TAG IN W SIDE POWER POLE S20°E 53.30'
- TOP CENTERLINE RR RAIL POST N35°E 59.02'
- NW CORNER HSE (SIDING) S40°W 115.82'
- S 1/4 POST SEC.33 (F-13) EAST 28.71'
- CENTERLINE OF ROAD NORTH 3.5'±

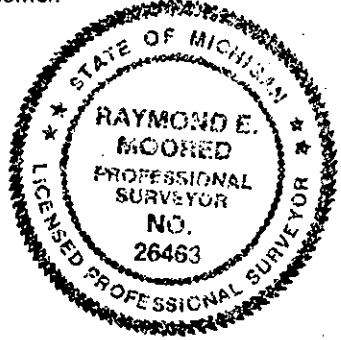

Signed by Raymond Moored
Surveyor's Michigan License No. 26463

Date 11/4/96