

**SURVEY & REMONUMENTATION**

NOV 04 1996

COMMISSION

STATE OF MICHIGAN  
COUNTY OF BARRY  
RECORDS & DEEDS

Oct 17 3 16 PM '96

Sandy Schmalzer  
REGISTERED DEEDS

**LAND CORNER RECORDATION CERTIFICATE**  
Filing Requirement of Act 74, Mich. P.A. 1970

For corners in

<u>BARRY</u> (County)	Located In:	Corner Code #
<u>CASTLETON TOWNSHIP</u>	T <u>3N</u> R <u>7W</u>	<u>F-13</u>
1. Public Land Survey	T _____ R _____	_____
	T _____ R _____	_____
	T _____ R _____	_____
	T _____ R _____	_____
2. Property Controlling in Section	S _____ T _____ R _____	_____
	S _____ T _____ R _____	_____
3. Miscellaneous Property in Sec.	S _____ T _____ R _____	_____
	S _____ T _____ R _____	_____

**002407**

Register of Deeds Stamp & File Number

- 4. Lot No. \_\_\_\_\_, Recorded Plat \_\_\_\_\_
- 5. Private Claims \_\_\_\_\_

A	B	C	D	E	F	G	H	I	J	K	L	M
2	6	5	4	3	2	1						
3												
4	7	8	9	10	11	12						
5												
6	10	17	16	15	14	13						
7												
8	19	20	21	22	23	24						
9												
10	30	29	28	27	26	25						
11												
12	31	32	33	34	35	36						
13												

I, DAVID L. CLIFFORD in a field survey on SEPTEMBER 24, 1996, do hereby certify that under requirements of P.A. 74, Michigan P.A. of 1970, the corner points mentioned in lines 1 and 2 above were in conformance with regulations and rules therefore as required in the current manual of survey instructions of the United States Department of the Interior, Bureau of Land Management or by a decree of a Court of Law and/or that the corner points mentioned in lines 3, 4 and 5 above were in conformance with the rules of the Michigan Board of Land Surveyors or by a Decree of a Court of Law, established, re-established, monumented, re-monumented, recovered, found as expressed below:

**NOTE: Not more than 4 corners, all in the same town and range, may be recorded on this certificate.**

A. Description of original monument and accessories and/or subsequent restoration:

- POST SET IN ORIGINAL GOVERNMENT SURVEY BY LUCIUS LYON, DEPUTY SURVEYOR, IN DECEMBER 1825 AND TWO BEARING TREES RECORDED:  
SUGAR 18" N28E 33 LKS (21.8')  
BEECH 6" N53W 42 LKS (27.7')
- I FIND NO FURTHER MENTION OF CORNER IN PUBLIC OR PRIVATE RECORDS.


B. Description of corner evidence found and/or method applied in restoring or reestablishing corner:

SEARCHED AT APPARENT LOCATION OF CORNER AND FOUND ANCHOR POST IN EAST-WEST FENCE AT FENCE TO NORTH AND 18.6 FEET WEST OF FENCE TO SOUTH. TRAVERSE OF THE SOUTH LINE OF SECTION 33, T3N, R7W AND SECTION 4, T2N, R7W SHOW FENCE CORNER TO BE ALMOST A SPLIT OF ENTIRE MEASURED DISTANCE ALONG THE SECTION LINE. ACCEPTED FENCE CORNER AS CORNER AS PERPETUATED BY AN UNKNOWN SURVEYOR AND SET STANDARD BARRY COUNTY MONUMENT IN THE REMAINS OF SAID FENCE CORNER.

**ACT 345 BARRY COUNTY REMONUMENTATION**  
APPROVED BY PEER REVIEW AT A MEETING HELD ON  
OCT 9, 1995  
BRIAN REYNOLDS COUNTY SURVEYOR

C. Description of monument for corner and accessories established to perpetuate locating the position of the corner:

F-13 T3N R7W  
3/4" DIAMETER STEEL BAR AND ALUMINUM CAP IMPRINTED "BARRY COUNTY REMONUMENTATION PS 31602 28409" IN REMAINS OF ANCIENT FENCE POST.  
NAIL AND TAG 28409 IN NW SIDE OF 30" BEECH, 80° NAZ., 45.13'  
NAIL AND TAG 28409 IN WEST SIDE OF 18" ASH, 356° NAZ., 21.44'  
NAIL AND TAG 28409 IN EAST SIDE OF 5" BEECH, 164° NAZ., 11.38'  
NAIL AND TAG 28409 IN WEST SIDE OF 14" TWIN ASH, 130° NAZ., 49.78'  
3/4" BAR & ALUMINUM CAP IMPRINTED PS 31602 28409(F-1 T2N R7W), 95° NAZ., 18.64'

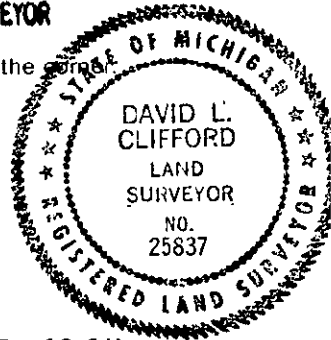

Signed by David Clifford Date OCTOBER 08, 1996  
Surveyor's Michigan License No. 25837