

SURVEY & REMONUMENTATION

MAY 20 1987

COMMISSION

BARRY COUNTY REMONUMENTATION
LAND CORNER RECORDATION CERTIFICATE
Filing Requirement of Act 74, Mich. P.A. 1970

STATE OF MICHIGAN
COUNTY OF BARRY
RECEIVED

Dec 9 2 09 PM '96

Sandy Schanzelmarjer
REGISTER OF DEEDS

002429

Register of Deeds Stamp & File Number

For corners in	Located In:	Corner Code #
<u>BARRY</u> (County)		
1. Public Land Survey	T <u>3</u> R <u>7W</u>	<u>G-2</u>
1/4 COR COMMON TO SEC'S 3 & 4 CASTLETON TWP.	T <u> </u> R <u> </u>	<u> </u>
2. Property Controlling in Section	T <u> </u> R <u> </u>	<u> </u>
3. Miscellaneous Property in Sec.	S <u> </u> T <u> </u> R <u> </u>	<u> </u>
	S <u> </u> T <u> </u> R <u> </u>	<u> </u>

4. Lot No. _____, Recorded Plat _____
5. Private Claims _____

I, RAYMOND MOORED, in a field survey on SEPT, 1995 do hereby state that under requirements of P.A. 74, Michigan P.A. of 1970, the corner points mentioned in lines 1 and 2 above were in conformance with regulations and rules therefore as required in the current manual of survey instructions of the United States Department of the Interior, Bureau of Land Management or by a decree of a Court of Law and /or that the corner points mentioned in lines 3, 4 and 5 above were in conformance with the rules of the Michigan Board of Land Surveyors or by a Decree of a Court of Law; established, re-established, monumented, recovered, found as expressed below:

NOTE: Not more than 2 corners, all in the same town and range, may be recorded on this certificate.

	A	B	C	D	E	F	G	H	I	J	K	L	M
1													
2		6		5		4	●	3		2		1	
3													
4		7		8		9		10		11		12	
5													
6		18		17		16		15		14		13	
7													
8		19		20		21		22		23		24	
9													
10		30		29		28		27		26		25	
11													
12		31		32		33		34		35		36	
13													

A. Description of original monument and accessories and/or subsequent restoration:

G.L.O. SYLVESTER SIBLEY D.S. 1830 (R7W, P.107) A. BEECH 9. S. 31.E. 34. DO. 10. N15W 12. COUNTY SURVEYOR RECORDS BEARINGS FOUND A.D. RORK JUNE 20, 1866 (L2, P.105)

B. Description of corner evidence found and/or method applied in restoring or reestablishing corner:


FOUND NO EVIDENCE OF CORNER LOCATION. ESTABLISHED CORNER ON STRAIGHT LINE BETWEEN NORTHEAST AND SOUTHEAST CORNERS ON EAST AND WEST QUARTER LINE OCCUPATION. ACCEPTED AS BEST AVAILABLE EVIDENCE OF CORNER LOCATION. SET STANDARD BARRY COUNTY REMONUMENTATION IRON WITH CAP.

ACT 345 BARRY COUNTY REMONUMENTATION
APPROVED BY PEER REVIEW AT A MEETING HELD ON

13 Nov. '95 BR
BRIAN REYNOLDS COUNTY SURVEYOR

C. Description of monument for corner and accessories established to perpetuate locating the position of the corner:

SET STANDARD BARRY COUNTY REMONUMENTATION IRON WITH CAP
-NAIL IN N SIDE RR TIE FENCE POST N90°W 36.79'
-NAIL IN E SIDE RR TIE FENCE POST S25°W 106.12'
-NAIL IN E SIDE 4" POPLAR S55°W 34.81'
-NAIL IN E SIDE 6" POPLAR N40°W 58.36'

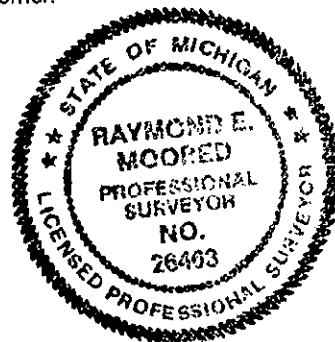

Signed by Raymond Moored
Surveyor's Michigan License No. 26463

Date 11/4/96