

CURTIS W. REMONUMENTATION

MAY 29 1997

COMMISSION

BARRY COUNTY REMONUMENTATION
LAND CORNER RECORDATION CERTIFICATE
Filing Requirement of Act 74, Mich. P.A. 1970

STATE OF MICHIGAN
COUNTY OF BARRY
RECORDS DEPARTMENT

DEC 9 2 09 PM '96

Sandra Schindelman
REGISTER OF DEEDS

For corners in

BARRY

(County)

Located In:

Corner Code #

- 1. Public Land Survey
CASTLETON TWP.
1/4 COR COMMON TO
SEC'S 3, 4, 9 & 10
- 2. Property Controlling
in Section
- 3. Miscellaneous
Property in Sec.

	T <u>3</u>	R <u>7W</u>	<u>G-3</u>
	T	R	
	T	R	
	T	R	
S	T	R	
S	T	R	
S	T	R	
S	T	R	

002430

Register of Deeds Stamp & File Number

- 4. Lot No. _____, Recorded Plat _____
- 5. Private Claims _____

	A	B	C	D	E	F	G	H	I	J	K	L	M
1													
2	6		5			4		3		2			1
3													
4	7		8			9		10		11			12
5													
6	18		17			16		15		14			13
7													
8	19		20			21		22		23			24
9													
10	30		29			28		27		26			25
11													
12	31		32			33		34		35			36
13													

I, RAYMOND E. MOORED, in a field survey on SEPT, 19 95 do hereby state that under requirements of P.A. 74, Michigan P.A. of 1970, the corner points mentioned in lines 1 and 2 above were in conformance with regulations and rules therefore as required in the current manual of survey instructions of the United States Department of the Interior, Bureau of Land Management or by a decree of a Court of Law and/or that the corner points mentioned in lines 3, 4 and 5 above were in conformance with the rules of the Michigan Board of Land Surveyors or by a Decree of a Court of Law; established, re-established, monumented, recovered, found as expressed below:

NOTE: Not more than 2 corners, all in the same town and range, may be recorded on this certificate.

A. Description of original monument and accessories and/or subsequent restoration:

G.L.O. SYLVESTER SIBLEY D.S. 1830 (R7W, P. 107) A. MAPLE 7. S. 33 W. 25. A. BEECH 12 N. 26 W 18. RR. IRON NW COR. HOUSE S.E. 61.2' 8" CHERRY SW 50.1' FC. POST NW 45' FC. POST NE 39.2'

B. Description of corner evidence found and/or method applied in restoring or reestablishing corner:


FOUND NO EVIDENCE OF CORNER LOCATION. EXTENDED LINE FROM SOUTH QUARTER POST THROUGH CENTERLINE OF ROAD AT NORTH-SOUTH 1/8 LINE OCCUPATION IN SOUTHEAST QUARTER. ACCEPTED AS BEST AVAILABLE EVIDENCE OF CORNER LOCATION. SET STANDARD BARRY COUNTY REMONUMENTATION IRON WITH CAP.

ACT 345 BARRY COUNTY REMONUMENTATION
APPROVED BY PEER REVIEW AT A MEETING HELD ON

13 NOV. '95
BRIAN REYNOLDS COUNTY SURVEYOR

C. Description of monument for corner and accessories established to perpetuate locating the position of the corner:

- SET STANDARD BARRY COUNTY REMONUMENTATION IRON WITH CAP
- NAIL IN SW. SIDE 8" PINE N40°W 63.30'
- NAIL IN NW SIDE POWER POLE S45°W 27.23'
- NAIL IN N SIDE 8" POPLAR S75°E 84.12'
- NAIL IN SW SIDE 10" PINE N45°W 87.46'
- CENTERLINE BAYNE ROAD NORTH 7'+/-

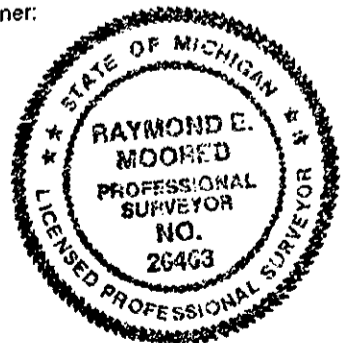

Signed by Raymond Moored
Surveyor's Michigan License No. 26463

Date 11/4/96