

CORNER TO
REMONUMENTATION
MAY 20 1997

BARRY COUNTY REMONUMENTATION
LAND CORNER RECORDATION CERTIFICATE
Filing Requirement of Act 74, Mich. P.A. 1970

STATE OF MICHIGAN
COUNTY OF BARRY
RECORDS DEPARTMENT

DEC 9 2 09 PM '96

Sandy Schmalzmayor
REGISTER OF DEEDS

002423

For Corners in REMONUMENTATION Located In: BARRY Corner Code #

- 1. Public Land Survey T..3N R..7WK-1.....
SEC. COR. COMMON TO T..... R.....
SEC'S. 1 & 2 T..... R.....
CASTLETON TWP. T..... R.....
- 2. Property Controlling S.....T..... R.....
in Section S.....T..... R.....
- 3. Miscellaneous S..... T..... R.....
Property in Sec. S..... T..... R.....
- 4. Lot No....., Recorded Plat.....
- 5. Private Claims.....

Register of Deeds Stamp & File Number

I, RAYMOND MOORED, in a field survey on 9 AUGUST, 1994 do hereby state that under requirements of P.A. 74, Michigan P.A. of 1970, the corner points mentioned in lines 1 and 2 above were in conformance with regulations and rules therefore as required in the current manual of survey instructions of the United States Department of the Interior, Bureau of Land Management or by a decree of a Court of Law and/or that the corner points mentioned in lines 3, 4, and 5 above were in conformance with the rules of the Michigan Board of Land Surveyors or by a Decree of a Court of Law; established, re-established, monumented, recovered, found as expressed below.


NOTE: Not more than 2 corners, all in the same town and range, may be recorded on this certificate.

| | A | B | C | D | E | F | G | H | I | J | K | L | M |
|----|----|---|----|---|----|---|----|---|----|---|----|---|---|
| 1 | | | | | | | | | | | | | |
| 2 | 6 | | 5 | | 4 | | 3 | | 2 | | 1 | | |
| 3 | | | | | | | | | | | | | |
| 4 | 7 | | 8 | | 9 | | 10 | | 11 | | 12 | | |
| 5 | | | | | | | | | | | | | |
| 6 | 18 | | 17 | | 16 | | 15 | | 14 | | 13 | | |
| 7 | | | | | | | | | | | | | |
| 8 | 19 | | 20 | | 21 | | 22 | | 23 | | 24 | | |
| 9 | | | | | | | | | | | | | |
| 10 | 30 | | 29 | | 28 | | 27 | | 26 | | 25 | | |
| 11 | | | | | | | | | | | | | |
| 12 | 31 | | 32 | | 33 | | 34 | | 35 | | 36 | | |
| 13 | | | | | | | | | | | | | |

A. Description of original monument and accessories and/or subsequent restoration:
GLO S. SIBLEY, D.S. 1830 (R7W, P.98) NORTH 81.92 NORTH 81.92 TO NORTH BNDRY 80 LKS WEST OF POST, SET COR TO SEC. 1 & 2, B.ASH 6 S53E 40 ELM 12 S67W 67. CO. SURVEYOR RECORDS A. C. WILLSON 10 SEPT 1880 (L1, P 98) BURIED STONE AND TILE FROM WOODLAND CORNER. CO. ROAD COMM - IRON 8" W. CHERRY N79E 83.97', 21" MAPLE S20E 61.93', 16" ELM S55W 60.20'. MDOT RECORDS - COR COMM. TO SEC'S 1, 2, 35, 36 1/2" IRON PIN 17.12' LT OF STA 284+59.88 (3'+/- FILL AT C/L) (FROM MSHD PROJ 8-32 CONST PLANS, 1957) WITNESSES SAME AS ROAD COMM ABOVE. MSHD COVERT ROAD HIGHWAY PLANS, PG. 11, NO DATE, CORNER TO CASTLETON AND WOODLAND TWPS., 8" APPLE 61.8' SW; DOUBLE WILLOW 31.4' WEST.

B. Description of corner evidence found and/or method applied in restoring or reestablishing corner:
FOUND IRON BAR IN MON BOX PER MDOT INFORMATION ABOVE. NO OLD WITNESSES REMAINED. ACCEPTED POSITION AS BEST AVAILABLE EVIDENCE OF CORNER LOCATION. REMOVED IRON BAR AND SET STANDARD BARRY COUNTY REMONUMENTATION IRON WITH CAP.

C. Description of monument for corner and accessories established to perpetuate locating the position of the corner:
SET STANDARD BARRY COUNTY REMONUMENTATION IRON WITH CAP IN MON BOX
-NAIL & TAG IN W'LY SIDE 30" MAPLE S45°E 118.93'
-NAIL & TAG IN S SIDE 6" POST N85°W 74.54'
-NORTH CORNER OF CONC R/W POST S70°E 133.38'
-NAIL & TAG IN N'LY SIDE POWER POLE S45°W 98.72'
- SE COR SEC. 35, WOODLAND, EAST 53.10'

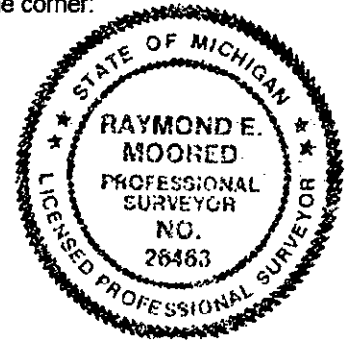

Signed by Raymond Moored
Surveyor's Michigan License No. 26463

Date 12/2/96

ACT 345 BARRY COUNTY REMONUMENTATION
APPROVED BY PEER REVIEW AT A MEETING HELD ON
13 NOV. '95 BR
BRIAN REYNOLDS COUNTY SURVEYOR