STATE OF MICHIGAN
COUNTY OF BARRY
RECEIVED FOR RECORD

DEC 7 3 41 PM '93

Sandy Schondelmayer
REGISTER OF DEEDS

002112

Register of Deeds Stamp & File Number

BARRY COUNTY REMONUMENTATION
LAND CORNER RECORDATION CERTIFICATE
Filing Requirement of Act 74, Mich. P.A. 1970

For corners in

BARRY COUNTY
(County)

CASTLETON TOWNSHIP

		Located In:	Corner Code ##
1. Public Land Survey		T 3 N R 7 W	M-12
		T ___ R ___	
		T ___ R ___	
		T ___ R ___	
2. Property Controlling	S ___	T ___ R ___	
in Section	S ___	T ___ R ___	
3. Miscellaneous	S ___	T ___ R ___	
Property in Sec.	S ___	T ___ R ___	

4. Lot No. _____, Recorded Plat _____
5. Private Claims _____

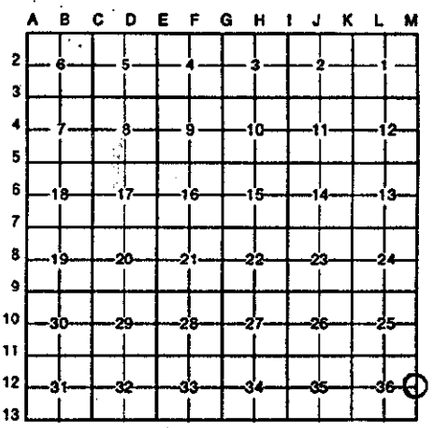

I, ROBERT R. CARR, in a field survey on NOVEMBER 9, 19 93, do hereby certify that under requirements of P.A. 74, Michigan P.A. of 1970, the corner points mentioned in lines 1 and 2 above were in conformance with regulations and rules therefore as required in the current manual of survey instructions of the United States Department of the Interior, Bureau of Land Management or by a decree of a Court of Law and/or that the corner points mentioned in lines 3, 4 and 5 above were in conformance with the rules of the Michigan Board of Land Surveyors or by a Decree of a Court of Law; established, re-established, monumented, re-monumented, recovered, found as expressed below:

NOTE: Not more than 4 corners, all in the same town and range, may be recorded on this certificate.

A. Description of original monument and accessories and/or subsequent restoration:

M-12 GLO BEECH 20" S29°W 22 LKS; BEECH 10" N43°W 41 LKS.
SURVEYS IN SE 1/4 SECTION 36 BY COUNTY SURVEYOR COBB IN 1904 & 1911 INDICATE HE USED WEST 1/4 SECTION 36 BUT GAVE NO DESCRIPTION OR BEARINGS.
LCRC NO. 193, ROBERT C. REED, APRIL 28, 1976, FOUND IRON BAR IN CENTERLINE COUNTY LINE ROAD; RAIL ROAD TIE FENCE CORNER POST EAST 21 FEET; 15" WALNUT NNE 90 FEET; M.B. TELEPHONE POLE WNW 70 FEET.

B. Description of corner evidence found and/or method applied in restoring or reestablishing corner:

M-12 FOUND OLD 1-3/4" X 1" X 18" IRON BAR SET IN STONES AND POTTERY, MATCHING WITNESSES BY REED TO M.B. TELEPHONE POLE AND 15" WALNUT.
ALSO FOUND NEW 1/2" IRON WESTERLY 0.8 FEET.
ALSO FOUND NEW 1/2" IRON WESTERLY 0.8 FEET AND NORTHERLY 2.64 FEET WITH CAP P.S. NO. 18988.
ACCEPTED OLD IRON BAR SET IN STONE AND POTTERY AS TRUE PERPETUATION OF CORNER.

SURVEY &
REMONUMENTATION

APR 0 5 1994

COMMISSION

C. Description of monument for corner and accessories established to perpetuate locating the position of the corner:

M-12 REPLACED OLD IRON STAKE WITH STANDARD BARRY COUNTY REMON 3/4" STEEL ROD AND ALUMINUM CAP WITH CENTER PUNCH.
NAIL AND SPOTTER IN NE SIDE OF U-POLE N66°W 70.48 FEET.
NAIL AND SPOTTER IN SE SIDE OF 24" WALNUT N20°E 89.76 FEET.
NAIL AND SPOTTER IN S SIDE OF U-POLE N88°E 28.55 FEET.
TOP NUT OF FIRE HYDRANT N20°W 68.61 FEET.
4 FEET EAST OF CENTERLINE ROAD (NEW PAVEMENT); IN LINE WITH FENCE EAST.
3 FEET SOUTH OF CENTERLINE ROAD TO WEST.

STATE OF MICHIGAN
ROBERT R. CARR
PROFESSIONAL SURVEYOR
No. 20704
LICENSED PROFESSIONAL SURVEYOR

Signed by _____ Date NOV 10, 1993
ROBERT R. CARR
Surveyor's Michigan License No. 20704

FORM APPROVED BY MICHIGAN STATE BOARD OF LAND SURVEYORS, JAN. 28, 1971
REVISED MAY 14, 1975
REVISED JAN., 1983