

SURVEY & REMONUMENTATION

BARRY COUNTY REMONUMENTATION

FEB 03 1999

LAND CORNER RECORDATION CERTIFICATE  
Filing Requirement of Act 74, Mich. P.A. 1970

SECTION  
For Corners in  
BARRY  
(county)

Located In:

Corner Code #



2708

Page: 1 of 1  
11/25/1998 12:13P

Sandy Schondelmayer - Barry Co. LCRCR

1. Public Land Survey  
TOWNSHIP CORNER  
COMMON TO  
TOWNSHIPS 2 & 3 NORTH,  
RANGES 6 & 7 WEST

T 2N R 7W  
T 2N R 6W  
T 3N R 7W  
T 3N R 6W

M-1  
A-1  
M-13  
A-13

2. Property Controlling  
in Section

S \_\_\_ T \_\_\_ R \_\_\_  
S \_\_\_ T \_\_\_ R \_\_\_

3. Miscellaneous  
Property in Sec.

S \_\_\_ T \_\_\_ R \_\_\_  
S \_\_\_ T \_\_\_ R \_\_\_

4. Lot No \_\_\_\_\_, Recorded Plat \_\_\_\_\_  
5. Private Claims \_\_\_\_\_

Register of Deeds Stamp & File Number

T3N R7W

M-13

I, Brian Reynolds, in a field survey on 17 OCTOBER, 1996 do hereby certify that under requirements of P.A. 74, Michigan P.A. of 1970, the corner points mentioned in lines 1 and 2 above were in conformance with regulations and rules therefore as required in the current manual of survey instructions of the United States Department of the Interior, Bureau of Land Management or by a decree of a Court of Law and/or that the corner points mentioned in lines 3, 4, and 5 above were in conformance with the rules of the Michigan Board of Land Surveyors or by a Decree of a Court of Law, established, re-established, monumented, re-monumented, recovered, found as expressed below.

A	B	C	D	E	F	G	H	I	J	K	L	M
2	6	5	4	3	2	1						
3												
4	7	8	9	10	11	12						
5												
6	15	17	16	15	14	13						
7												
8	19	20	21	22	23	24						
9												
10	30	29	28	27	26	25						
11												
12	31	32	33	34	35	36						
13												

NOTE: Not more than 2 corners, all in the same town and range, may be recorded on this certificate.

A. Description of original monument and accessories and/or subsequent restoration:


1. GENERAL LAND OFFICE: JOHN MULLETT, 1825 (R7W, P. 51) BIRCH 7 N41W 18 BIRCH 7 S45 1/2W 34
2. BARRY COUNTY SURVEYOR RECORDS: A.N. BATEMAN, AUG. 7, 1899 (L.2,P.295 & L.3,P.6) "FOUND N.E. CORNER" S20°E 51 FT. IS AN 8" ELM N80°W 2 RD. IS A 4" CHERRY
3. CORNER IS NOT MENTIONED IN THE RECORDS OF THE EATON COUNTY SURVEYOR.

\*\*\* NO OTHER HISTORICAL INFORMATION, PUBLIC OR PRIVATE, AVAILABLE FOR THIS CORNER \*\*\*

B. Description of corner evidence found and/or method applied in restoring or reestablishing corner:  
FOUND 1/2" IRON IN CIRCLE OF SMALL STONES AT INTERSECTION OF GRAVEL ROADS NORTH-SOUTH-EAST.  
ACCEPTED FOUND IRON IN CIRCLE OF SMALL STONES AS BEST AVAILABLE EVIDENCE OF CORNER POSITION.  
REPLACED FOUND IRON WITH STANDARD BARRY COUNTY REMONUMENTATION MONUMENT (WITH ALUMINUM CAP).

C. Description of monument for corner and accessories established to perpetuate locating the position of the corner:  
SET STANDARD BARRY COUNTY REMONUMENTATION MONUMENT (WITH ALUMINUM CAP)  
SET 20d NAIL W/REMON TAG IN THE NORTH SIDE OF A UTILITY POLE N86°W 34.59'  
SET 20d NAIL W/REMON TAG IN THE EAST SIDE OF A 12" WALNUT S27°W 49.58'  
SET 20d NAIL W/REMON TAG IN THE EAST SIDE OF A 10" MAPLE S18°W 55.96'  
SET 20d NAIL W/REMON TAG IN THE WEST SIDE OF A 12" ASH S24°E 61.04'  
SET 20d NAIL W/REMON TAG IN THE SOUTHWEST SIDE OF A WOOD CORNER POST S59°E 47.11'  
IN LINE WITH FENCE WEST; ON CENTERLINE OF GRAVEL ROAD EAST (KINSEL HIGHWAY)  
1.5' +/- WEST OF CENTERLINE OF NORTH-SOUTH GRAVEL ROAD (CURTIS ROAD)

ACT 345 BARRY COUNTY REMONUMENTATION  
APPROVED BY PEER REVIEW AT A MEETING HELD ON  
Nov 9, 1998 BR  
BRIAN REYNOLDS COUNTY SURVEYOR

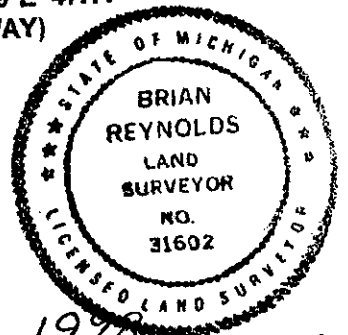

Signed by [Signature]  
Surveyor's Michigan License No 31602

Date Nov 24, 1998  
FORM APPROVED BY MICHIGAN STATE BOARD OF LAND SURVEYORS JAN. 28, 197  
REVISED MAY 14, 1975 REVISED JANUARY, 1983 REVISED OCTOBER 1995