

SURVEY & REMONUMENTATION

APR 26 1995

COMMISSION

Barry County Remonumentation
LAND CORNER RECORDATION CERTIFICATE
Filing Requirement of Act 74, Mich. P.A. 1970

STATE OF MICHIGAN
COUNTY OF BARRY
RECEIVED FOR RECORD


DEC 8 8 15 AM '94

Sandy Schondelmar
REGISTER OF DEEDS

002249

Register of Deeds Stamp & File Number

For corners in <u>Barry</u> <small>(County)</small>	Located In:	Corner Code #
1. Public Land Survey	T <u>3N</u> R <u>9W</u>	<u>M-1 (NE, 1)</u>
	T <u> </u> R <u> </u>	<u>Rutland Twp.</u>
	T <u>4N</u> R <u>9W</u>	<u>M-13 (SE, 36)</u>
	T <u> </u> R <u> </u>	<u>Irving Twp.</u>
2. Property Controlling in Section	S <u> </u> T <u>4N</u> R <u>8W</u>	<u>A-13 (SW, 31)</u>
	S <u> </u> T <u> </u> R <u> </u>	<u>Carlton Twp.</u>
3. Miscellaneous Property in Sec.	S <u> </u> T <u>3N</u> R <u>8W</u>	<u>A-1 (NW, 6)</u>
	S <u> </u> T <u> </u> R <u> </u>	<u>Hasting Twp.</u>
4. Lot No. _____, Recorded Plat _____		
5. Private Claims _____		

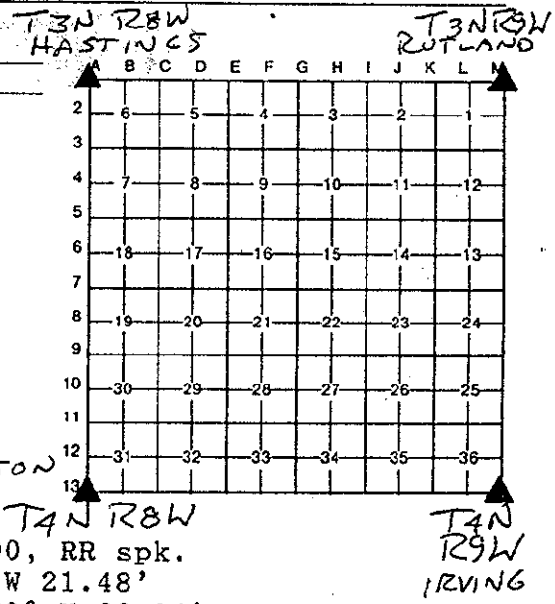

John C. Bueche, in a field survey on September, 19 94,
do hereby certify that under requirements of P.A. 74, Michigan P.A. of 1970, the corner points mentioned
in lines 1 and 2 above were in conformance with regulations and rules therefore as required in the
current manual of survey instructions of the United States Department of the Interior, Bureau of Land
Management or by a decree of a Court of Law and/or that the corner points mentioned in lines 3, 4 and 5
above were in conformance with the rules of the Michigan Board of Land Surveyors or by a Decree of a
Court of Law; established, re-established, monumented, re-monumented, recovered, found as
expressed below:

NOTE: Not more than 4 corners, all in the same town and range, may be recorded on this certificate.

Description of original monument and accessories and/or subsequent restoration:

M-1 GLO Post	LCRC #413, 7-90, RR spk.
W. Oak 18" S 35 lks.	30" Oak N 05° W 21.48'
W. Oak 11" N 53° E 6 lks.	10" Cherry N 70° W 69.34'
L. Lyons, D.S., 1826	C/L Rd. 3'± S
	In line fence N

Description of corner evidence found and/or method applied in restoring or reestablishing corner:

M-1 Found RR spk., on top of stone (4" top, 8" bottom, 15" high)
As per above wit.

Accepted as a careful and faithful perpetuation of the position of the original corner.

ACT 345 BARRY COUNTY REMONUMENTATION
APPROVED BY PEER REVIEW AT A MEETING HELD ON
4 OCT 94
BRIAN REYNOLDS COUNTY SURVEYOR

Description of monument for corner and accessories established to perpetuate locating the position of the corner:

M-1 Replaced stone & RR spk. with Barry Co. Mon. (3/4" x 24" Pin with Alum. Cap)
Nail & Barry Co. Remon. Tag in S side 10" Maple N 75° W 97.40'
Nail & Barry Co. Remon. Tag in SW side 6" Maple N 55° W 59.60'
Nail & Barry Co. Remon. Tag in SW side 10" W. Cherry N 50° W 49.97'
40d Nail & RLS Cap #31602 in W side 36" Oak N 5° W 21.48'
C/L gravel E-W, N 3'±, on old fence line North

Signed by John C. Bueche
Surveyor's Michigan License No. 13027

Date 10-26-94

