

BARRY COUNTY REMONUMENTATION

LAND CORNER RECORDATION CERTIFICATE
Filing Requirement of Act 74, Mich. P.A. 1970

SURVEY &
REMONUMENTATION

APR 04 2000

SECTION

For Corners in BARRY Located In: _____ Corner Code # _____
(county)

1. Public Land Survey T 3N R 8W _____
WEST 1/4 CORNER T _____ R _____
SECTION 18 T _____ R _____
HASTINGS TOWNSHIP T _____ R _____
ON RANGE LINE _____
2. Property Controlling S _____ T _____ R _____
in Section S _____ T _____ R _____
3. Miscellaneous S _____ T _____ R _____



2861
Page: 1 of 1
12/27/1999 01:44P

Darla K. Burghdoff - Barry Co. LCRCR

Register of Deeds Stamp & File Number

4. Lot No _____, Recorded Plat _____
5. Private Claims _____

I, Brian Reynolds, in a field survey on 24 MAY, 1999 do hereby certify that under requirements of P.A. 74, Michigan P.A. of 1970, the corner points mentioned in lines 1 and 2 above were in conformance with regulations and rules therefore as required in the current manual of survey instructions of the United States Department of the Interior, Bureau of Land Management or by a decree of a Court of Law and/or that the corner points mentioned in lines 3, 4, and 5 above were in conformance with the rules of the Michigan Board of Land Surveyors or by a Decree of a Court of Law; established, re-established, monumented, re-monumented, recovered, found as expressed below.

NOTE: Not more than 2 corners, all in the same town and range, may be recorded on this certificate.


	A	B	C	D	E	F	G	H	I	J	K	L	M
1													
2	6	5	4	3	2	1							
3													
4	7	8	9	10	11	12							
5													
6	18	17	16	15	14	13							
7													
8	19	20	21	22	23	24							
9													
10	30	29	28	27	26	25							
11													
12	31	32	33	34	35	36							
13													

- A. Description of original monument and accessories and/or subsequent restoration:
1. THIS CORNER WAS NOT SET BY THE GENERAL LAND OFFICE.
 2. COUNTY ROAD COMMISSION: NO NAME OR DATE, "3" CLAY POST & SCRAP IRON" 24" ASH N15°E 87.54' 30" B.E. S88°E 86.80' 11" POPLAR N85°W 55.10' P.P. N25°W 67.13'
 3. COUNTY ROAD COMMISSION: NO NAME, 4-10-67, "A-5 TO A-6 2646.45' 20.46' NORTH OF RUTLAND CORNER"
 4. STATE HIGHWAY DEPARTMENT: WITNESS CARD, F. K. HOLMES, #14094, 1-24-67, SAME WITNESSES AS IN #3 ABOVE
 5. CONSUMERS POWER COMPANY: P. I. McPHERSON, 7-73 (F.B., P.1016) "FND BOAT SPIKE IN MON BOX" 36" BOX ALDER N85°E 85.7' 14" MULBERRY S68°E 135.85' MON BOX SOUTH 20.46'
 6. LAND CORNER RECORDATION CERTIFICATE: #70, BY WILLIAM HUME ROGERS, P.S. #6197, 01-26-1973 "3" CLAY POST AND SCRAP IRON MONUMENT BOX" N15°E 87.34' 24" ASH. N25°W 67.13' POWER POLE
 7. ACT 132 SURVEY: BY WILLIAM HUME ROGERS, P.S. #6197, 2-20-1973 (L-1, P.101) RECITE SAME WITNESSES AS IN #6 ABOVE

B. Description of corner evidence found and/or method applied in restoring or reestablishing corner:
APPARENT CORNER LOCATION LIES IN A NORTH-SOUTH BITUMINOUS ROAD (COOK ROAD). THIS SEGMENT OF COOK ROAD WAS REBUILT BY MDOT IN THE EARLY 1970'S AS PART OF THE RELOCATION OF M-37/M-43. ALL PRE-CONSTRUCTION WITNESSES FOR BOTH THE STANDARD AND CLOSING CORNERS WERE DESTROYED DURING CONSTRUCTION. FOUND IRONS AND MON BOXES APPARENTLY REPRESENTING THE SUBJECT CLOSING AND CORRESPONDING STANDARD CORNERS. AFTER TRAVERSING FROM A-5 TOA-7, INCLUDING STANDARD CORNERS, IT APPEARS THAT AFTER CONSTRUCTION, MDOT RESTORED THE CORRESPONDING STANDARD CORNER (M-6 T3N R9W) PROPERLY, THEN ATTEMPTED TO RESTORE THE SUBJECT CLOSING CORNER THE PROPER DISTANCE BUT THE WRONG DIRECTION FROM THE STANDARD CORNER. TIES TO PRE-CONSTRUCTION SURVEYS ON BOTH SIDES OF THE RANGE LINE CONFIRMS THIS. EXCAVATED 20.46 FEET NORTH OF THE NORTHERNMOST MON BOX TO A DEPTH OF 7 FEET BELOW ROAD GRADE, FOUND NOTHING. ACCEPTED THE NORTHERNMOST IRON IN MON BOX AS PROPER RESTORATION OF CORRESPONDING STANDARD CORNER, SET STANDARD BARRY COUNTY REMONUMENTATION MONUMENT 20.46 FEET NORTH OF STANDARD CORNER ON RANGE LINE AND INSTALLED MONUMENT BOX.

C. Description of monument for corner and accessories established to perpetuate locating the position of the corner:
SET STANDARD BARRY COUNTY REMONUMENTATION MONUMENT (3/4" X 36" IRON) WITH ALUMINUM CAP.
INSTALLED MONUMENT BOX.
SET 20d NAIL W/PLASTIC TAG IN THE SOUTH SIDE OF A 10" MAPLE S43°E 55.70'
FOUND CHISELED "X" TOP OF A FIRE HYDRANT S29°E 57.75'
SET 20d NAIL W/PLASTIC TAG IN THE NORTHWEST SIDE OF A 10" ELM N54°E 68.14'
BARRY COUNTY MONUMENT IN MONUMENT BOX (M-6 RUTLAND TOWNSHIP) S00°E 20.46'
FOUND BOAT SPIKE IN MONUMENT BOX (REPRESENTING NOTHING) S00°E 40.94'
CORNER LIES ON NORTH-SOUTH PAINTED CENTERLINE

ACT 345 BARRY COUNTY REMONUMENTATION
APPROVED BY PEER REVIEW AT A MEETING HELD ON
14 June, 99 BR
BRIAN REYNOLDS COUNTY SURVEYOR

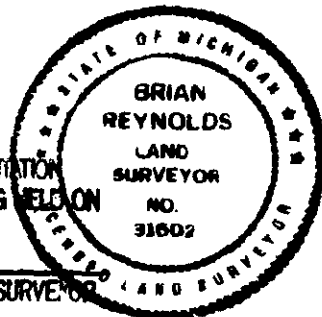

Signed by [Signature]
Surveyor's Michigan License # 31602

Date DEC 27, 1999