

SURVEY & REMONUMENTATION

SEP 13 1994

COMMISSION

N1/4 COR SEC 18
HASTINGS
BARRY COUNTY REMONUMENTATION
LAND CORNER RECORDATION CERTIFICATE
Filing Requirement of Act 74, Mich. P.A. 1970

STATE OF MICHIGAN
COUNTY OF BARRY
RECEIVED FOR RECORD

MAR 16 4 24 PM '94

Sandy Schindelmarzen
REGISTER OF DEEDS

002184

Register of Deeds Stamp & File Number

For corners in

<u>BARRY</u> (County)	Located In:	Corner Code #
1. Public Land Survey	T <u>3N</u> R <u>8W</u>	<u>B-5</u>
	T _____ R _____	_____
	T _____ R _____	_____
	T _____ R _____	_____
2. Property Controlling in Section	S _____ T _____ R _____	_____
	S _____ T _____ R _____	_____
3. Miscellaneous Property in Sec.	S _____ T _____ R _____	_____
	S _____ T _____ R _____	_____
4. Lot No. _____, Recorded Plat _____		
5. Private Claims _____		

A	B	C	D	E	F	G	H	I	J	K	L	M
2	6	5	4	3	2	1						
3												
4	7	8	9	10	11	12						
5												
6	18	17	16	15	14	13						
7												
8	19	20	21	22	23	24						
9												
10	30	29	28	27	26	25						
11												
12	31	32	33	34	35	36						
13												

I, BRIAN REYNOLDS, in a field survey on JANUARY 5, 19 94, do hereby certify that under requirements of P.A. 74, Michigan P.A. of 1970, the corner points mentioned in lines 1 and 2 above were in conformance with regulations and rules therefore as required in the current manual of survey instructions of the United States Department of the Interior, Bureau of Land Management or by a decree of a Court of Law and/or that the corner points mentioned in lines 3, 4 and 5 above were in conformance with the rules of the Michigan Board of Land Surveyors or by a Decree of a Court of Law; established, re-established, monumented, re-monumented, recovered, found as expressed below:

NOTE: Not more than 4 corners, all in the same town and range, may be recorded on this certificate.

A. Description of original monument and accessories and/or subsequent restoration:

CORNER SET BY DEP. SURVEYOR SLYVESTER SIBLEY UNDER CONTRACT DATED 16 MARCH 1831
SET POST BEECH 9 S35 1/2 E 42
LYNN 14 N55°W 11
1975 SURVEY BY WILLIAMS & WORKS - SET 'T' FENCE POST AT INTERSECTION OF N-S AND E FENCES.


B. Description of corner evidence found and/or method applied in restoring or reestablishing corner:

FOUND "T" FENCE POST AS ESTABLISHED BY WILLIAMS AND WORKS. DURING 1975 SURVEY, W & W DETERMINED THAT GOVT. PRORATION OF N SEC. LINE WOULD FALL 100'± E OF "T" FENCE POST AT FENCE INTERSECTION. MEASURED 100' TO EAST ALONG FENCE AND DUG. FOUND 8"X10"X24" LIMESTONE W/POINTED TOP LYING ON SIDE. EXCAVATED FURTHER AT BASE OF STONE AND FOUND 2 SECTIONS OF 3" CLAY TILE. REMOVED UPPER SECTION OF TILE AND SET BARRY CO. REMON. IRON OVER LOWER SECTION OF TILE.

ACT 345 BARRY COUNTY REMONUMENTATION
APPROVED BY PEER REVIEW AT A MEETING HELD ON
JAN 12, 1994 BR
BRIAN REYNOLDS COUNTY SURVEYOR

C. Description of monument for corner and accessories established to perpetuate locating the position of the corner:

BARRY COUNTY REMON. IRON W/CAP
NAIL & TAG E SIDE 12" CHERRY N8°E 8.45'
NAIL & TAG N SIDE 12" ELM S71°E 9.24'
NAIL & TAG SE SIDE 12" ASH S70°W 21.29'
NAIL & TAG S SIDE 16" SYCAMORE N33°W 44.06'
"T" FENCE POST IN N, S, AND E FENCE WEST 100.04'
IN OLD DOWNED E-W FENCE

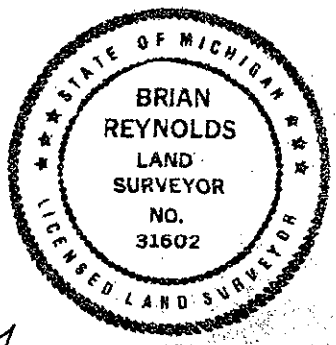

Signed by [Signature] Date 3/7/94
Surveyor's Michigan License No. 31602