

**SURVEY & REMONUMENTATION**

FEB 17 1998

**BARRY COUNTY REMONUMENTATION**

LAND CORNER RECORDATION CERTIFICATE  
Filing Requirement of Act 74, Mich. P.A. 1970

SECTION

002518

For Corners in <u>BARRY</u> (county)	Located In:	Corner Code #
1. Public Land Survey CORNER COMMON TO SECTIONS 31 & 32 HASTINGS TOWNSHIP ON TOWNSHIP LINE	T <u>3N</u> R <u>8W</u>	<u>C-13</u>
2. Property Controlling in Section	T _____ R _____ S _____ T _____ R _____	_____
3. Miscellaneous Property in Sec.	S _____ T _____ R _____ S _____ T _____ R _____	_____
4. Lot No. _____, Recorded Plat _____		
5. Private Claims _____		

STATE OF MICHIGAN  
BARRY COUNTY  
RECORDED

31 JUL 97 9:04 A.M.

SANDY SCHONDELMEYER  
REGISTER OF DEEDS

Register of Deeds Stamp & File Number

I, **Brian Reynolds**, in a field survey on **16 MAY, 1997** do hereby certify that under requirements of P.A. 74, Michigan P.A. of 1970, the corner points mentioned in lines 1 and 2 above were in conformance with regulations and rules therefore as required in the current manual of survey instructions of the United States Department of the Interior, Bureau of Land Management or by a decree of a Court of Law and/or that the corner points mentioned in lines 3, 4, and 5 above were in conformance with the rules of the Michigan Board of Land Surveyors or by a Decree of a Court of Law; established, re-established, monumented, re-monumented, recovered, found as expressed below.

NOTE: Not more than 2 corners, all in the same town and range, may be recorded on this certificate.

A. Description of original monument and accessories and/or subsequent restoration:

- GENERAL LAND OFFICE: JOHN MULLETT, D.S., 1826 (R8W,P.94) MAPLE 16 N53E 04 BEECH 8 N67W 30
- COUNTY SURVEYOR RECORDS: BOWEN, MARCH 1877(L.1,P.190) "BEARINGS NEARLY GONE" W. OAK 6 N76W 1.37 B. OAK 5 N12W 119
- COUNTY ROAD COMMISSION: #601 ROAD PLANS, 1921(FIELD BOOK P.3)"FOUND TWO IRON RODS ADJACENT IN MIDDLE OF E-W ROAD & ROAD N. FOUND WOODEN STAKE 19.4' E (FOR NE COR 6-2-8)" 36" OAK N30°W 77.0' 24" OAK N80°E 43.8' 20" OAK S60°E 60.2'
- ALSO: FOUND STONE (NO DATE) 20" ELM S6°W 34.0' 30" OAK S60°E 58.3' 24" OAK N65°E 94.1' "STONE IS 4.5' S & 3' W OF P.I."
- ALSO: (NO DATE) "1 1/4" IRON PIPE N EDGE OF GRAVEL" SPIKE IN POWER POLE S7°W 47.0' CENTER OF 30" (?) N60°E 38.0' NW COR. HOUSE S 25°E 59.75'
- ALSO: "2 IRON RODS" (NO DATE) SAME AS 4 ABOVE PLUS 36" OAK N30°W 77' 24" OAK N60°E 43.8' 20" OAK S60°E 60.2'
- ALSO: "IRON" (NO DATE) 16" MAPLE S 20" COR POST S30°E 37.8' FC POST S40°W 39.9'
- ALSO: SAGER ROAD PLANS (NO DATE) "FOUND IRON" P. POLE S45°W 71.0' 36" OAK S60°E 58.55'
- LAND CORNER RECORDATION CERTIFICATE: #241, BY ROBERT R. CARR, P.S.#20704, NOV. 1976, "R.R. SPIKE" 19' WEST OF SOUTH FENCE LINE 18" OAK S60°E 59.85' APPROXIMATE CENTERLINE PAVEMENT
- ACT 132 SURVEY: BY ROY F. DeHAVEN, P.S.#3380, 11-26-1976 (L.1,P.357-358) "3/4" IRON MARKER" 34" WHITE OAK S60°E 58.4' POWER POLE S45°W 70.7' 12" WALNUT S2°W 118.7'

B. Description of corner evidence found and/or method applied in restoring or reestablishing corner:

FOUND RAILROAD SPIKE AND THE FOLLOWING WITNESSES: OAK S60°E (ITEM #3,#4,#6,#8,#9,&#10 ABOVE), WALNUT S2°W (ITEM #10 ABOVE).

ACCEPTED FOUND RAILROAD SPIKE AS A PROPER PERPETUATION OF CORNER POSITION.

REPLACED FOUND RAILROAD SPIKE WITH STANDARD BARRY COUNTY REMONUMENTATION MONUMENT AND INSTALLED MONUMENT BOX.

C. Description of monument for corner and accessories established to perpetuate locating the position of the corner:

SET STANDARD BARRY COUNTY REMONUMENTATION MONUMENT (3/4" X 36" IRON) WITH ALUMINUM CAP.

SET "PK" IN THE NORTH SIDE OF A UTILITY POLE S42°W 71.22'

SET 20d NAIL W/REMON TAG IN THE WEST SIDE OF A 24" WALNUT SOUTH 119.39'

SET 20d NAIL W/REMON TAG IN THE WEST SIDE OF A 22" WALNUT S1°E 137.63'

SET 20d NAIL W/REMON TAG IN THE WEST SIDE OF A 48" QUAD OAK S15°E 156.51'


FOUND NAIL IN THE NORTHWEST SIDE OF A 48" OAK S59°E 60.72'

C-1 T2N,R8W LIES S89°42'33"E 19.33'

CORNER LIES ON EAST-WEST CENTERLINE ON EXTENDED CENTERLINE FROM NORTH

ACT 345 BARRY COUNTY REMONUMENTATION  
APPROVED BY PEER REVIEW AT A MEETING HELD ON

MAY 13, 1996 BR  
BRIAN REYNOLDS COUNTY SURVEYOR

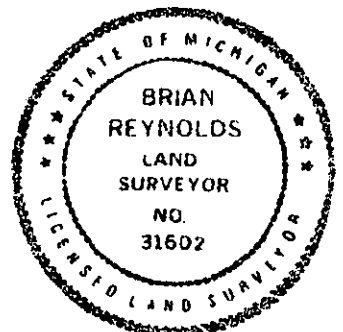

Signed by [Signature]  
Surveyor's Michigan License No 31602

Date July 30, 1997