

SURVEY & REMONUMENTATION

FEB 17 1998

SECTION

BARRY COUNTY REMONUMENTATION

LAND CORNER RECORDATION CERTIFICATE
Filing Requirement of Act 74, Mich. P.A. 1970

For Corners in
BARRY
(county)

Located In:

Corner Code #



2616

Page: 1 of 1
09/16/1997 11:48A

Sandy SchondeImayer - Barry Co. LCRCR

1. Public Land Survey
SOUTH 1/4 CORNER
SECTION 32
HASTINGS TOWNSHIP
ON TOWNSHIP LINE

T 3N R 8W
T _____ R _____
T _____ R _____
T _____ R _____

D-13

2. Property Controlling
in Section

S _____ T _____ R _____
S _____ T _____ R _____

3. Miscellaneous
Property in Sec.

S _____ T _____ R _____
S _____ T _____ R _____

Register of Deeds Stamp & File Number

4. Lot No _____, Recorded Plat _____
5. Private Claims _____

A	B	C	D	E	F	G	H	I	J	K	L	M
2	6	5	4	3	2	1						
3												
4	7	8	9	10	11	12						
5												
6	18	17	16	15	14	13						
7												
8	19	20	21	22	23	24						
9												
10	30	29	28	27	26	25						
11												
12	31	32	33	34	35	36						
13												

I, Brian Reynolds, in a field survey on 16 MAY, 1997 do hereby certify that under requirements of P.A. 74, Michigan P.A. of 1970, the corner points mentioned in lines 1 and 2 above were in conformance with regulations and rules therefore as required in the current manual of survey instructions of the United States Department of the Interior; Bureau of Land Management or by a decree of a Court of Law and/or that the corner points mentioned in lines 3, 4, and 5 above were in conformance with the rules of the Michigan Board of Land Surveyors or by a Decree of a Court of Law; established, re-established, monumented, re-monumented, recovered, found as expressed below.

NOTE: Not more than 2 corners, all in the same town and range, may be recorded on this certificate.

A. Description of original monument and accessories and/or subsequent restoration:


1. GENERAL LAND OFFICE: JOHN MULLETT, D.S., 1826 (R8W,P.94) W. OAK 20 N61E 10 HICK 6 N27W 89
2. COUNTY SURVEYOR RECORDS: A.D. RORK, MARCH 9, 1866 (L.2,P.81) SOUTH 79.62 (FROM D-11) TO S1/4 POST
3. ALSO: BOWEN, DEC. 1877 (L.1,P.215) "FOUND W. OAK STUMP CLAIMED TO BE WITNESS SET STAKE & STONE FOR CORNER (GREGORY CLAIMS CORNER IS EAST STUMP)
4. CONSUMERS POWER COMPANY: (NO DATE) "LIME STONE" 14" TWIN W. OAK N35 3/4"E 19.3' 8" W. OAK N12"W 14'

*** NO OTHER RECORDED HISTORICAL INFORMATION AVAILABLE FOR THIS CORNER ***

B. Description of corner evidence found and/or method applied in restoring or reestablishing corner:
FOUND NO EVIDENCE OF CORNER MONUMENTATION. ALL WITNESSES FROM CONSUMERS POWER COMPANY (ITEM #4 ABOVE) ARE GONE. BELIEVE MONUMENT AND WITNESSES TO HAVE BEEN DESTROYED DURING ROAD CONSTRUCTION. CORNER LIES IN A 10'+/- CUT AREA. ESTABLISHED POSITION BY PROJECTING LINE AND DISTANCE FROM D-12 (FOUND STONE) THROUGH OCCUPATION CORNER MIDWAY BETWEEN D-12 AND D-13. POSITION THUS ESTABLISHED IS CONSISTANT WITH ROAD LOCATION AND OCCUPATION LINES. ACCEPTED AS BEST AVAILABLE EVIDENCE OF CORNER POSITION.
SET STANDARD BARRY COUNTY REMONUMENTATION MONUMENT.

C. Description of monument for corner and accessories established to perpetuate locating the position of the corner:
SET STANDARD BARRY COUNTY REMONUMENTATION MONUMENT (3/4" X 36" IRON) WITH ALUMINUM CAP.
SET 20d NAIL W/REMON TAG IN THE EAST SIDE OF A UTILITY POLE S24°E 62.23'
SET 20d NAIL W/REMON TAG IN THE NORTH SIDE OF A 10" HICKORY S71°E 98.29'
SET 20d NAIL W/REMON TAG IN THE WEST SIDE OF A 6" OAK N60°E 74.58'
SET 20d NAIL W/REMON TAG IN THE EAST SIDE OF AN 8" WALNUT N53°E 99.23'
D-1 T2N, R8W LIES N89°56'40"E 20.59'
CORNER LIES ON EAST-WEST CENTERLINE 2'+/- EAST OF A LINE OF ELECTRIC POLES RUNNING NORTH

ACT 345 BARRY COUNTY REMONUMENTATION
APPROVED BY PEER REVIEW AT A MEETING HELD ON
13 May, '96
BRIAN REYNOLDS
COUNTY SURVEYOR

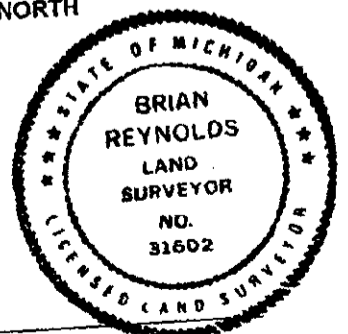

Signed by [Signature]
Surveyor's Michigan License No. 31602

Date 9/15/97
FORM APPROVED BY MICHIGAN STATE BOARD OF LAND SURVEYORS. JAN. 28, 1971
REVISED MAY 14, 1975 REVISED JANUARY, 1983 REVISED OCTOBER 1995