

1993

COMMISSION

**BARRY COUNTY REMONUMENTATION
LAND CORNER RECORDATION CERTIFICATE
Filing Requirement of Act 74, Mich. P.A. 1970**

STATE OF MICHIGAN
COUNTY OF BARRY
RECEIVED FOR RECORD

JUL 20 11 20 AM '93

Sandy Schendelmarjer
REGISTER OF DEEDS

002047

Register of Deeds Stamp & File Number

For corners in
BARRY
(County)

Located In: Corner Code #

- | | | |
|---------------------------------------|------------------|-------------------------|
| 1. Public Land Survey | 3N 8W G-9 | |
| | T R | HASTINGS TOWNSHIP |
| | T R | (COR. SEC. 21-22-27-28) |
| | T R | |
| 2. Property Controlling in Section | S T R | |
| | S T R | |
| 3. Miscellaneous Property in Sec. | S T R | |
| | S T R | |
| 4. Lot No. _____, Recorded Plat _____ | | |
| 5. Private Claims _____ | | |

	A	B	C	D	E	F	G	H	I	J	K	L
2	6	5	4	3	2	1						
3												
4	7	8	9	10	11	12						
5												
6	13	17	16	15	14	13						
7												
8	19	20	21	22	23	24						
9												
10	30	29	28	27	26	25						
11												
12	31	32	33	34	35	36						
13												

I, **BRIAN REYNOLDS**, in a field survey on **19 APR**, 19**93**, do hereby certify that under requirements of P.A. 74, Michigan P.A. of 1970, the corner points mentioned in lines 1 and 2 above were in conformance with regulations and rules therefore as required in the current manual of survey instructions of the United States Department of the Interior, Bureau of Land Management or by a decree of a Court of Law and/or that the corner points mentioned in lines 3, 4 and 5 above were in conformance with the rules of the Michigan Board of Land Surveyors or by a Decree of a Court of Law; established, re-established, monumented, re-monumented, recovered, found as expressed below:

NOTE: Not more than 4 corners, all in the same town and range, may be recorded on this certificate.

A. Description of original monument and accessories and/or subsequent restoration:

COBB (PG. 16, BOOK IX) (15 JUN 1888)

Set stake, Stone, & Brick (Stone & Brick for witnesses, 50 links West & South)

LCRC # 72, Francis E. Spicer (4/16/73): "T" IRON SET AT DOUBLE DIST. TO 1/8 LINE FENCE AND ON C/L ROAD EXTENDED E.


**12" WILLOW S80W 72.50' - 14" WD CHERRY S10W 28.18'
16" ELM N70W 70.5' - 8" HICKORY N35W 29.69'**

B. Description of corner evidence found and/or method applied in restoring or reestablishing corner:

Found 14" wild cherry & 16" elm (both now larger) from LCRC # 72. Reset corner from these witnesses.

C. Description of monument for corner and accessories established to perpetuate locating the position of the corner:

**SET 36" x 3/4" Dia. iron pipe w/Remonumentation Alum. cap & Punch hole.
On West edge of Thornapple River; +/-25' South of E-W fence;
40 D Nail, N. face 20" Elm, N70W, 70.5';
40 D Nail w/shiner, W. face 10" Hickory, N., 4.28';
" " " , W. face 8" Ash, N25W, 30.65';
" " " , E. face 12" Elm, S10E, 54.52';
" " " , E. face 20" Hickory, S20W, 27.82';
SE Cor. House Foundation, S70W, 142.75'**

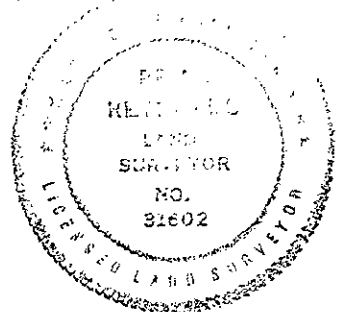

Signed by *Brian Reynolds* Date 7-13-1993
Surveyor's Michigan License No. 31602