SURVEY & REMONUMENTATION

JUL 2 4 1997

COMMISSION

BARRY COUNTY REMONUMENTATION

LAND CORNER RECORDATION CERTIFICATE

Filing Requirement of Act 74, Mich. P.A. 1970

For corners in **BARRY** (County)

	Located In:	Corner Code ##
1. Public Land Survey	T 3N R8W	H-10
CENTER OF SECTION	T ___ R ___	
27 HASTINGS TOWNSHIP	T ___ R ___	
	T ___ R ___	
2. Property Controlling	S ___ T ___ R ___	
in Section	S ___ T ___ R ___	
3. Miscellaneous	S ___ T ___ R ___	
Property in Sec.	S ___ T ___ R ___	

STATE OF MICHIGAN
BARRY COUNTY
RECORDED

17 JUN 97 12:21 P.M.

SANDY SCHONDELMAYER
REGISTER OF DEEDS

002507

Register of Deeds Stamp & File Number

4. Lot No. _____ , Recorded Plat _____
5. Private Claims _____

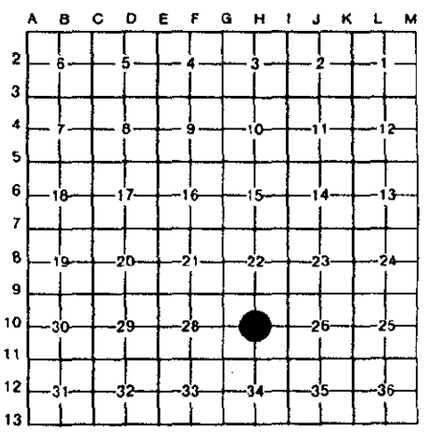

I, **BRIAN REYNOLDS**, in a field survey on **13 OCT.** , 19 **95**, do hereby certify that under requirements of P.A. 74, Michigan P.A. of 1970, the corner points mentioned in lines 1 and 2 above were in conformance with regulations and rules therefore as required in the current manual of survey instructions of the United States Department of the Interior, Bureau of Land Management or by a decree of a Court of Law and/or that the corner points mentioned in lines 3, 4 and 5 above were in conformance with the rules of the Michigan Board of Land Surveyors or by a Decree of a Court of Law; established, re-established, monumented, re-monumented, recovered, found as expressed below:

NOTE: Not more than 4 corners, all in the same town and range, may be recorded on this certificate.

A. Description of original monument and accessories and/or subsequent restoration:

CORNER NOT SET BY GENERAL LAND OFFICE.

NO OTHER RECORDED HISTORICAL INFORMATION AVAILABLE FOR THIS CORNER.

B. Description of corner evidence found and/or method applied in restoring or reestablishing corner:

FOUND INTERSECTION OF FENCES NORTH, EAST, & WEST. INTERSECTED 1/4 LINES.
INTERSECTION OF 1/4 LINES FALLS 2.8' NORTH OF EAST-WEST FENCE, & 4.3' WEST OF FENCE NORTH.
SET STANDARD BARRY COUNTY REMONUMENTATION MONUMENT AT INTERSECTION OF 1/4 LINES.

ACT 345 BARRY COUNTY REMONUMENTATION
APPROVED BY PEER REVIEW AT ~~A MEETING~~ HELD ON
4-8-96 BR
BRIAN REYNOLDS COUNTY SURVEYOR

ON

OR

C. Description of monument for corner and accessories established to perpetuate locating the position of the corner:

SET STANDARD BARRY COUNTY REMONUMENTATION MONUMENT (3/4"X36"W/ALUMINUM CAP)
2" ROUND SOLID IRON FENCE CORNER POST IN CONCRETE S56°E 5.20'
NORTH-SOUTH FENCE EAST 4.3'+/-
EAST-WEST FENCE SOUTH 2.8'+/-
G-10 T3N,R8W S89°20'42"W 2649.38'
H-11 T3N,R8W S0°44'45"E 2635.27'
H-9 T3N,R8W N0°44'45"W 2639.12'

STATE OF MICHIGAN
BRIAN REYNOLDS
LAND SURVEYOR
NO. 31602
LICENSED LAND SURVEYOR

Signed by _____ Date MAY 16, 1997

Surveyor's Michigan License No. 31602

FORM APPROVED BY MICHIGAN STATE BOARD OF LAND SURVEYORS, JAN. 28, 1971
REVISED MAY 14, 1975