

BARRY COUNTY REMONUMENTATION

LAND CORNER RECORDATION CERTIFICATE
Filing Requirement of Act 74, Mich. P.A. 1970

COURTNEY A. REYNOLDS
REGISTERED SURVEYOR

APR 04 2000

For Corners in BARRY Located In: _____ Corner Code # _____
(county)

SECTION _____

1. Public Land Survey T 3N R 8W _____
CORNER COMMON TO T _____ R _____
SECTIONS 2, 3, 10 & 11 T _____ R _____
HASTINGS TOWNSHIP T _____ R _____

2771
Page: 1 of 1
05/18/1999 02:53

2. Property Controlling S _____ T _____ R _____
in Section S _____ T _____ R _____

3. Miscellaneous S _____ T _____ R _____
Property in Sec. S _____ T _____ R _____

4. Lot No _____, Recorded Plat _____

5. Private Claims _____

Register of Deeds Stamp & File Number

I, **Brian Reynolds**, in a field survey on **10 AUGUST, 1997** do hereby certify that under requirements of P.A. 74, Michigan P.A. of 1970, the corner points mentioned in lines 1 and 2 above were in conformance with regulations and rules therefore as required in the current manual of survey instructions of the United States Department of the Interior, Bureau of Land Management or by a decree of a Court of Law and/or that the corner points mentioned in lines 3, 4, and 5 above were in conformance with the rules of the Michigan Board of Land Surveyors or by a Decree of a Court of Law, established, re-established, monumented, re-monumented, recovered, found as expressed below.

A	B	C	D	E	F	G	H	I	J	K	L	M
1												
2	6	5	4	3	2	1						
3								●				
4	7	8	9	10	11	12						
5												
6	18	17	16	15	14	13						
7												
8	19	20	21	22	23	24						
9												
10	30	29	28	27	26	25						
11												
12	31	32	33	34	35	36						
13												

NOTE: Not more than 2 corners, all in the same town and range, may be recorded on this certificate.


- A. Description of original monument and accessories and/or subsequent restoration:
- GENERAL LAND OFFICE: SYLVESTER SIBLEY, D.S., 1830 (R8W, P.111) A BEECH 8 N72W 43 Do. 10 S80E 46
 - COUNTY SURVEYOR RECORDS: LEE S. COBB OCT. 1889 (BOOK IX, P. 65 & L.2, P. 263) "FOUND REMAINS OF 3 OLD STAKES: SET STONE 18 x 9 x 8 & W. BRICK"
 - CONSUMERS POWER COMPANY: McPHERSON, SEPT. 1970 (FIELD BOOK 919) "NO COR. FD. LOCATED FROM STKS SHOWN FOUND STONE WITH 3 BRICKS AROUND BOTTOM OF STONE" T. MAPLE S42°W 14.82' STEEL FENCE IN CONC. N1½E 25.8' 8" ASH S71E 23.28' 4'+/- S CENTERLINE OLD ROAD GRADE
 - PRIVATE NOTES OF SURVEY: BY BRIAN REYNOLDS, P.S. #31602, 25, JUNE 1992 (JOB #92502) "SET ½" RE-ROD W/CAP SURROUNDED BY STONE" 2" STEEL FENCE COR. IN CONC. N7E 26.22' TWIN MAPLE IN E-W FENCE ROW N25W 31.39' 12" ASH S70E 23.21' 18" ASH S15W 23.32' 4'+/- SOUTH OF CENTERLINE OLD ROAD BED

*** NO OTHER HISTORICAL INFORMATION, PUBLIC OR PRIVATE, AVAILABLE FOR THIS CORNER ***

B. Description of corner evidence found and/or method applied in restoring or reestablishing corner:
FOUND REYNOLDS CAPPED IRON AND ALL WITNESSES FROM #4 ABOVE.
EXCAVATION REVEALED NO FURTHER EVIDENCE.
ACCEPTED CORNER POSITION BY McPHERSON AS PROPER PERPETUATION OF CORNER POSITION BY COBB.
ACCEPTED CAPPED IRON BY REYNOLDS AS PROPER RESTORATION OF CORNER POSITION BY McPHERSON.
REPLACED FOUND IRON WITH STANDARD BARRY COUNTY REMONUMENTATION MONUMENT.

C. Description of monument for corner and accessories established to perpetuate locating the position of the corner:
SET STANDARD BARRY COUNTY REMONUMENTATION MONUMENT (3/4" X 36" IRON) WITH ALUMINUM CAP.
IRON FENCE CORNER POST N01°E 26.28'
FOUND NAIL & TAG IN THE WEST SIDE OF A 28" TWIN MAPLE N27°W 31.39'
FOUND NAIL & TAG IN THE NORTH SIDE OF A 14" OAK S66°E 23.21'
FOUND NAIL & TAG IN THE WEST SIDE OF AN 18" OAK S02°W 23.38'
CORNER LIES 4' +/- SOUTH OF ABANDONED EAST-WEST ROAD
IN LINE WITH FENCES NORTH-SOUTH

ACT 345 BARRY COUNTY REMONUMENTATION
 APPROVED BY PEER REVIEW AT A MEETING HELD ON
9 Feb. '98
 BRIAN REYNOLDS COUNTY SURVEYOR

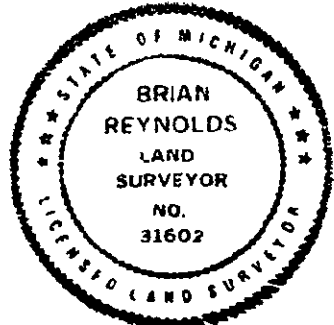

Signed by [Signature]
 Surveyor's Michigan License No 31602

Date MAY 18, 1999