

BARRY COUNTY REMONUMENTATION

LAND CORNER RECORDATION CERTIFICATE
Filing Requirement of Act 74, Mich. P.A. 1970

SURVEY &
RECORDATION

APR 04 2000

SECTION

For Corners in BARRY Located In: _____ Corner Code # _____
(county)

1. Public Land Survey T 3N R 8W 1-4
 1/4 CORNER COMMON TO T _____ R _____
 SECTIONS 10 & 11 T _____ R _____
 HASTINGS TOWNSHIP T _____ R _____



2772
Page: 1 of 1
05/18/1999 02:53

2. Property Controlling S _____ T _____ R _____
 in Section S _____ T _____ R _____

Register of Deeds Stamp & File Number

3. Miscellaneous S _____ T _____ R _____
 Property in Sec. S _____ T _____ R _____

4. Lot No _____, Recorded Plat _____

5. Private Claims _____

I, **Brian Reynolds**, in a field survey on **10 AUGUST, 1997** do hereby certify that under requirements of P.A. 74, Michigan P.A. of 1970, the corner points mentioned in lines 1 and 2 above were in conformance with regulations and rules therefore as required in the current manual of survey instructions of the United States Department of the Interior, Bureau of Land Management or by a decree of a Court of Law and/or that the corner points mentioned in lines 3, 4, and 5 above were in conformance with the rules of the Michigan Board of Land Surveyors or by a Decree of a Court of Law; established, re-established, monumented, re-monumented, recovered, found as expressed below.

1	A	B	C	D	E	F	G	H	I	J	K	L	M
2	6	5	4	3	2	1							
3													
4	7	8	9	10	11	12							
5													
6	18	17	16	15	14	13							
7													
8	19	20	21	22	23	24							
9													
10	30	29	28	27	26	25							
11													
12	31	32	33	34	35	36							
13													

NOTE: Not more than 2 corners, all in the same town and range, may be recorded on this certificate.

A. Description of original monument and accessories and/or subsequent restoration:

1. GENERAL LAND OFFICE: SYLVESTER SIBLEY, D.S., 1830 (R8W, P.111) A.B. ASH 20 N5W 3 Do. 22 S28E 17
2. COUNTY SURVEYOR RECORDS: FRANK BOWEN, 1877 (L.1, P.195) B. ASH 12 N37W 24 ELM 15 N53 1/2 E 28 1/2
3. CONSUMERS POWER COMPANY: NO NAME OR DATE, "SOLID IRON BRICK ON TOP"
 36" MAPLE NE 43' 24" WILD CHERRY SE 47.25'

*** NO OTHER HISTORICAL INFORMATION, PUBLIC OR PRIVATE, AVAILABLE FOR THIS CORNER***

B. Description of corner evidence found and/or method applied in restoring or reestablishing corner:

**FOUND 3/4" +/- SOLID IRON AT THE BASE OF A NORTH-SOUTH-EAST-WEST FENCE CORNER 6" +/- UNDER WATER.
 FOUND NO WITNESSES FROM CONSUMERS POWER SURVEY.**

ACCEPTED FOUND 3/4" SOLID IRON AS BEST AVAILABLE EVIDENCE OF CORNER POSITION.

COULD NOT REMOVE FOUND IRON. SET A PIPE WITH BARRY COUNTY REMONUMENTATION (ALUMINUM) CAP OVER THE TOP OF FOUND IRON.


C. Description of monument for corner and accessories established to perpetuate locating the position of the corner:

**SET STANDARD BARRY COUNTY REMONUMENTATION MONUMENT (3/4" X 36" IRON) WITH ALUMINUM CAP.
 SET 20d NAIL W/PLASTIC TAG IN THE SOUTH SIDE OF A 10" MAPLE S74°E 22.46'
 SET 20d NAIL W/PLASTIC TAG IN THE EAST SIDE OF A 20" MAPLE N08°W 9.82'
 SET 20d NAIL W/PLASTIC TAG IN THE SOUTH SIDE OF A 28" OAK N77°W 18.81'
 SET 20d NAIL W/PLASTIC TAG IN THE EAST SIDE OF AN 8" MAPLE S11°E 13.99'
 IN LINE WITH FENCES (DECAYING) NORTH-SOUTH-EAST-WEST**

ACT 345 BARRY COUNTY REMONUMENTATION
 APPROVED BY PEER REVIEW AT A MEETING HELD ON

9 Feb. '98
 BRIAN REYNOLDS

BR
 COUNTY SURVEYOR

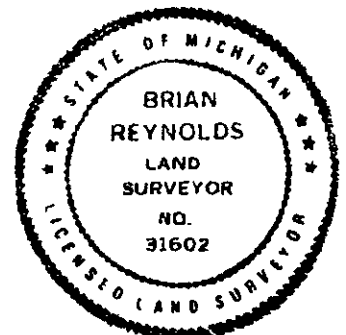

Signed by [Signature]
 Surveyor's Michigan License No 31602

Date MAY 18, 1999