

SURVEY & REMONUMENTATION

FEB 17 1998

SECTION

Barry County Remonumentation

LAND CORNER RECORDATION CERTIFICATE
Filing Requirement of Act 74, Mich. P.A. 1970

For corners in Barry

(County)	Located In:	Corner Code #
1. Public Land Survey	T 3N R 8W T R T R T R	I-5(NW 14) Hastings Twp.
2. Property Controlling in Section	S T R S T R	
3. Miscellaneous Property in Sec.	S T R S T R	




2619
 Page: 1 of 1
 10/20/1997 01:01P

Sandy Schonhelmayer - Barry Co. LCRCR

Register of Deeds Stamp & File Number

- 4. Lot No. _____, Recorded Plat _____
- 5. Private Claims _____

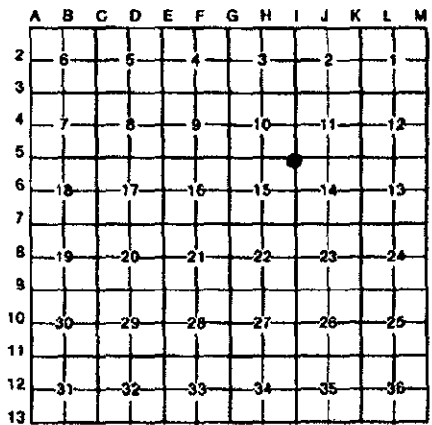

Steven Koerber August 31 1996

I, _____, in a field survey on _____, 19 _____, do hereby certify that under requirements of P.A. 74, Michigan P.A. of 1970, the corner points mentioned in lines 1 and 2 above were in conformance with regulations and rules therefore as required in the current manual of survey instructions of the United States Department of the Interior, Bureau of Land Management or by a decree of a Court of Law and/or that the corner points mentioned in lines 3, 4 and 5 above were in conformance with the rules of the Michigan Board of Land Surveyors or by a Decree of a Court of Law; established, re-established, monumented, re-monumented, recovered, found as expressed below:

NOTE: Not more than 4 corners, all in the same town and range, may be recorded on this certificate.

A. Description of original monument and accessories and/or subsequent restoration:

- 1-5 GLO - Sylvester Sibley D.S. 1830
 A.W. Ash 25 S77E 28
 A. Beech 11 N46W 44
- 1. Bowen- August 25, 1877
 Found roots of bearing tree & stone- Set stone & crockery for corner.
- 2. C.P.C.O.
 Fireclay post
 16" Hickory S47W 44.2'
 12" Butternut S47E 48.5'
 20" R. Oak N19E 90'

B. Description of corner evidence found and/or method applied in restoring or reestablishing corner:

- 1-5 Found no monument representing this corner. Set this corner by double proportion measurement. And is accepted as a careful and faithful reestablishment of the position of the original corner.

ACT 345 BARRY COUNTY REMONUMENTATION
APPROVED BY PEER REVIEW AT A MEETING HELD ON

SEPT 9 1996
 BRIAN REYNOLDS COUNTY SURVEYOR

C. Description of monument for corner and accessories established to perpetuate locating the position of the corner:

- 1-5 Set Standard Barry Co. Mon. (3/4" x 24" Iron Rod with Aluminum cap)
 Set PK nail & Barry Co. Remon. Tag in E. side P. Pole
 Set spike with Barry Co. Remon. Tag in NW side Util. pole
 NE cor. Hse. fndn.
 C/L 6" iron post remains in conc.
 C/L State Road
- | | |
|---------|---------|
| S 0° E | 49.26' |
| S 65° W | 141.68' |
| S 20° W | 111.84' |
| S 50° E | 58.9" |
| South | 5' |

Signed by Steven Koerber
 Surveyor's Michigan License No. 39085

Date 10-13-1997

