

**SURVEY & REMONUMENTATION**

1993

**COMMISSION**

**BARRY COUNTY REMONUMENTATION LAND CORNER RECORDATION CERTIFICATE**  
 Filing Requirement of Act 74, Mich. P.A. 1970

STATE OF MICHIGAN  
 COUNTY OF BARRY  
 RECEIVED FOR RECORD

JUL 20 11 20 AM '93

Sandy Schendelmayer  
 REGISTER OF DEEDS

For corners in BARRY  
 (County)

Located In: Corner Code #

- 1. Public Land Survey T 3N R 8W I-11  
 T \_\_\_\_\_ R \_\_\_\_\_ HASTINGS TOWNSHIP  
 T \_\_\_\_\_ R \_\_\_\_\_ (COR. SEC. 26 27 34 35)  
 T \_\_\_\_\_ R \_\_\_\_\_
- 2. Property Controlling S \_\_\_\_\_ T \_\_\_\_\_ R \_\_\_\_\_  
 in Section S \_\_\_\_\_ T \_\_\_\_\_ R \_\_\_\_\_
- 3. Miscellaneous S \_\_\_\_\_ T \_\_\_\_\_ R \_\_\_\_\_  
 Property in Sec. S \_\_\_\_\_ T \_\_\_\_\_ R \_\_\_\_\_

**002044**

Register of Deeds Stamp & File Number

- 4. Lot No. \_\_\_\_\_, Recorded Plat \_\_\_\_\_
- 5. Private Claims \_\_\_\_\_

A	B	C	D	E	F	G	H	I	J	K	L
2	6	5	4	3	2	1					
3											
4	7	8	9	10	11	12					
5											
6	18	17	16	15	14	13					
7											
8	19	20	21	22	23	24					
9											
10	30	29	28	27	26	25					
11											
12	31	32	33	34	35	36					
13											

I, BRIAN REYNOLDS, in a field survey on JAN, 1993, do hereby certify that under requirements of P.A. 74, Michigan P.A. of 1970, the corner points mentioned in lines 1 and 2 above were in conformance with regulations and rules therefore as required in the current manual of survey instructions of the United States Department of the Interior, Bureau of Land Management or by a decree of a Court of Law and/or that the corner points mentioned in lines 3, 4 and 5 above were in conformance with the rules of the Michigan Board of Land Surveyors or by a Decree of a Court of Law; established, re-established, monumented, re-monumented, recovered, found as expressed below:


**NOTE: Not more than 4 corners, all in the same town and range, may be recorded on this certificate.**

A. Description of original monument and accessories and/or subsequent restoration:

<b>G.L.O. :</b>	<b>Bowen 1878</b>	<b>Road Comm. (no date)</b>	<b>M.D.O.T.</b>
<b>Corner in stream</b>	<b>Set post in creek.</b>	<b>1 1/4" pipe</b>	<b>(Construction Plans)</b>
<b>No post or bearing trees.</b>	<b>Stake 50 N. set by</b>	<b>SE. corner rail N49E, 18.25'</b>	<b>Located 0.10' R. of Sta: 116+48.87</b>
	<b>"Haughtalin" as</b>	<b>NE. " " S51E, 17.93'</b>	<b>on survey C-L.</b>
<b>M.S.H.D. (1964)</b>	<b>boundary road.</b>	<b>NW. " " S53W, 17.95'</b>	<b>N51W NW corner of bridge 17.00'</b>
<b>1" cadium bolt</b>		<b>SW. " " N51W, 17.90'</b>	<b>N49E NE " " " 18.25'</b>
<b>Chisled "x" N. 20.41'</b>			<b>S51E SE " " " 17.93'</b>
<b>" " S45W 28.22'</b>			<b>S53W SW " " " 17.95'</b>
<b>" " S45E 28.22'</b>			<b>Reset corner in new bridge.</b>

B. Description of corner evidence found and/or method applied in restoring or reestablishing corner:

**Found iron bolt in bridge deck as per M.D.O.T. witnesses.**  
**Fits M.D.O.T. stationing E. & W. within tolerance.**

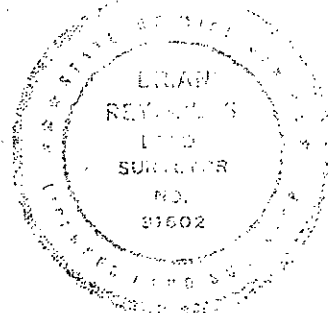

C. Description of monument for corner and accessories established to perpetuate locating the position of the corner:

**CHISLED "X" IN TOP OF IRON BOLT FOUND IN BRIDGE DECK.**  
**40 D NAIL W/BARRY Co. SHINER TOP OF FAR W. GUARD RAIL POST, S. SIDE M-79 S79W 118.38'**  
 " " " " " " " " " " " " " " " " N. " " " N72W 69.20'  
 " " " " " " " " " " " " " " " " E. " " " " " " " N67E 58.72'  
 " " " " " " " " " " " " " " " " S. " " " S70E 63.81'  
**E. SIDE UTIL. POLE N47W 85.53'**  
**E. SIDE 12" POPLAR S43E 68.35'**  
**+/- 0.3' S. PAINTED C/L, APPROX. CENTER OF BRIDGE DECK.**

Signed by [Signature]  
 Surveyor's Michigan License No. 31602

Date 7-13-93