

BARRY COUNTY REMONUMENTATION

LAND CORNER RECORDATION CERTIFICATE
Filing Requirement of Act 74, Mich. P.A. 1970

SURVEY &
REMONUMENTATION

APR 04 2000

For Corners in BARRY Located In: _____ Corner Code # _____
(county)

1. Public Land Survey T 3N R 8W J-3
 ¼ CORNER COMMON TO T _____ R _____
 SECTIONS 2 & 11 T _____ R _____
 HASTINGS TOWNSHIP T _____ R _____
2. Property Controlling S _____ T _____ R _____
 in Section S _____ T _____ R _____
3. Miscellaneous S _____ T _____ R _____
 Property in Sec. S _____ T _____ R _____
4. Lot No _____, Recorded Plat _____
5. Private Claims _____

SECTION
2773
Page: 1 of 1
05/18/1999 02:53P

Sandy Schondelmayer - Barry Co. LCRCR

Register of Deeds Stamp & File Number

I, **Brian Reynolds**, in a field survey on **10 AUGUST, 1998** do hereby certify that under requirements of P.A. 74, Michigan P.A. of 1970, the corner points mentioned in lines 1 and 2 above were in conformance with regulations and rules therefore as required in the current manual of survey instructions of the United States Department of the Interior, Bureau of Land Management or by a decree of a Court of Law and/or that the corner points mentioned in lines 3, 4, and 5 above were in conformance with the rules of the Michigan Board of Land Surveyors or by a Decree of a Court of Law; established, re-established, monumented, re-monumented, recovered, found as expressed below.

NOTE: Not more than 2 corners, all in the same town and range, may be recorded on this certificate.

A. Description of original monument and accessories and/or subsequent restoration:

- GENERAL LAND OFFICE: SYLVESTER SIBLEY, D.S., 1830 (R8W, P.112) "WEST CORRECTED 40.17"
A CHERRY 16 N29W 18 A BEECH 7 S14½E 27
- COUNTY SURVEYOR RECORDS: SETH PRATT, 1889 (L.1, P.321)"POINTED STONE & OLD SAP GOUGE" BITTERNUT 8 S53¾W 1
- COUNTY ROAD COMMISSION: NO NAME OR DATE, 12" TWIN ELM S40°W 39.1' 8" ELM S50°E 39.9' COR. POST N35°W 3'
- CHICAGO, KALAMAZOO & SAGINAW RAILROAD PLANS: FRANK C. BALCH, CHIEF ENGINEER, 1888 (L. 1 OF PLATS, PG. 34-1)
"1320 SOUTH OF R.R." NO WITNESSES GIVEN
- CONSUMERS POWER COMPANY: McPHERSON, SEPT. 1970 (FIELD BOOK 919) OF NW ¼ OF SECTION 11 DOES NOT DIRECTLY REFERENCE THIS CORNER, HOWEVER DOES REFERENCE J-4 AND 1/8 CORNER BETWEEN J-3 AND J-4 AS FOUND STONES, SET "T" IRONS AT BOTH LOCATIONS.
- PRIVATE NOTES OF SURVEY: BY BRIAN REYNOLDS, P.S. #31602, JUNE 25, 1992 (JOB #92502) NO MONUMENT FOUND, FOUND "T" IRONS AT J-4 AND ¼ MILE NORTH BY C.P. Co., ESTABLISHED POSITION BY PROJECTING LINE AND DISTANCE THROUGH FOUND "T" IRONS, EXCAVATION REVEALED NO FURTHER EVIDENCE OF MONUMENTATION. SET ½" RE-ROD W/C 17'+/- N. OF W. OCC. POWER POLE N10E 141.03' 7" BLK CHERRY S85W 50.45' POWER POLE S10E 223.20'

	A	B	C	D	E	F	G	H	I	J	K	L	M
1													
2	6	5	4	3	2								
3										●			
4	7	8	9	10	11	12							
5													
6	18	17	16	15	14	13							
7													
8	19	20	21	22	23	24							
9													
10	30	29	28	27	26	25							
11													
12	31	32	33	34	35	36							
13													

B. Description of corner evidence found and/or method applied in restoring or reestablishing corner:


FOUND ½" CAPPED IRON (REYNOLDS 31602) AS DESCRIBED IN #6 ABOVE.
 ACCEPTED FOUND ½" CAPPED IRON AS PROPER RESTORATION OF CORNER POSITION.
 REPLACED FOUND ½" CAPPED IRON WITH STANDARD BARRY COUNTY REMONUMENTATION MONUMENT.

C. Description of monument for corner and accessories established to perpetuate locating the position of the corner:

SET STANDARD BARRY COUNTY REMONUMENTATION MONUMENT (3/4" X 36" IRON) WITH ALUMINUM CAP.
 FOUND NAIL & TAG IN THE WEST SIDE OF A UTILITY POLE N11°E 140.63'
 FOUND NAIL & TAG IN THE WEST SIDE OF A UTILITY POLE S07°E 222.99'
 SET 20d NAIL W/PLASTIC TAG IN THE NORTH SIDE OF A 4" TWIN HICKORY S84°W 40.64'
 SET 20d NAIL W/PLASTIC TAG IN THE SOUTHEAST SIDE OF A 4" ASH S22°W 93.82'
 SET ½" x 18" IRON W/CAP (REYNOLDS 31602) WEST 33.00 FEET
 SET ½" x 18" IRON W/CAP (REYNOLDS 31602) S28°W 70.26'
 ON NORTH-SOUTH GRAVEL CENTERLINE

ACT 345 BARRY COUNTY REMONUMENTATION
 APPROVED BY PEER REVIEW AT A MEETING HELD ON

9 Feb. '98 BR
 BRIAN REYNOLDS COUNTY SURVEYOR

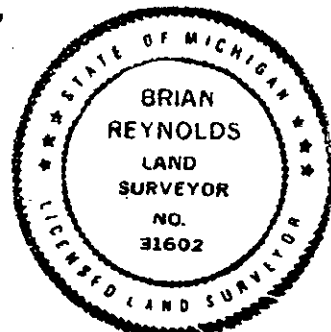

Signed by [Signature]
 Surveyor's Michigan License No 31602

Date MAY 18, 1998