

# BARRY COUNTY REMONUMENTATION

LAND CORNER RECORDATION CERTIFICATE  
Filing Requirement of Act 74, Mich. P.A. 1970

SURVEY &  
RECORDS  
APR 04 2000

APR 04 2000

SECTION

For Corners in BARRY Located In: \_\_\_\_\_ Corner Code # \_\_\_\_\_  
(county)

1. Public Land Survey T 3N R 8W J-4  
CENTER OF SECTION 11 T \_\_\_\_\_ R \_\_\_\_\_  
HASTINGS TOWNSHIP T \_\_\_\_\_ R \_\_\_\_\_  
T \_\_\_\_\_ R \_\_\_\_\_



**2774**  
Page: 1 of 1  
05/18/1999 02:53P

Sandy Schondelmayer- Barry Co. LCRCR

Register of Deeds Stamp & File Number

2. Property Controlling S \_\_\_\_\_ T \_\_\_\_\_ R \_\_\_\_\_  
in Section S \_\_\_\_\_ T \_\_\_\_\_ R \_\_\_\_\_

3. Miscellaneous S \_\_\_\_\_ T \_\_\_\_\_ R \_\_\_\_\_  
Property in Sec. S \_\_\_\_\_ T \_\_\_\_\_ R \_\_\_\_\_

4. Lot No \_\_\_\_\_, Recorded Plat \_\_\_\_\_

5. Private Claims \_\_\_\_\_

	A	B	C	D	E	F	G	H	I	J	K	L	M
1													
2	6	5	4	3	2	1							
3													
4	7	8	9	10	●	12							
5													
6	18	17	16	15	14	13							
7													
8	19	20	21	22	23	24							
9													
10	30	29	28	27	26	25							
11													
12	31	32	33	34	35	36							
13													

I, **Brian Reynolds**, in a field survey on **10 AUGUST, 1998** do hereby certify that under requirements of P.A. 74, Michigan P.A. of 1970, the corner points mentioned in lines 1 and 2 above were in conformance with regulations and rules therefore as required in the current manual of survey instructions of the United States Department of the Interior, Bureau of Land Management or by a decree of a Court of Law and/or that the corner points mentioned in lines 3, 4, and 5 above were in conformance with the rules of the Michigan Board of Land Surveyors or by a Decree of a Court of Law; established, re-established, monumented, re-monumented, recovered, found as expressed below.

NOTE: Not more than 2 corners, all in the same town and range, may be recorded on this certificate.

A. Description of original monument and accessories and/or subsequent restoration:

1. THIS CORNER WAS NOT SET BY THE GENERAL LAND OFFICE.
2. BARRY COUNTY ROAD COMMISSION: NO NAME OR DATE, 12" ELM S45W 35.4 T. POLE N87W 33.1 10" WALNUT S45E 39.6
3. CONSUMERS POWER COMPANY: P.I. McPHERSON, SEPT., 1970 (FILED BOOK 919) "FOUND LARGE STONE SET "T" IRON" 16" WALNUT S37E 39.84' TEL POLE N82W 34.15' ELM STUMP S45W 35.31'
4. PRIVATE NOTES OF SURVEY: BY BRIAN REYNOLDS, P.S. #31602, 25, JUNE 1992 (JOB #92502) "FD. "T" IRON & WALNUT WITNESS BY C.P. Co."
5. UNRECORDED SURVEY: BY KEN BRANDT, P.S. #24587, 13 OCTOBER, 1996


\*\*\* NO OTHER HISTORICAL DATA, PUBLIC OR PRIVATE, AVAILABLE FOR THIS CORNER \*\*\*

B. Description of corner evidence found and/or method applied in restoring or reestablishing corner:  
FOUND 1/2" x 18" CAPPED IRON (BRANDT, P.S. #24587). FOUND ONE WITNESS FROM ITEMS #2 & #3 ABOVE (WALL SOUTHEAST).  
ACCEPTED FOUND IRON BY BRANDT AS PERPETUATION OF CORNER POSITION McPHERSON.  
REPLACED BRANDT IRON WITH STANDARD BARRY COUNTY REMONUMENTATION MONUMENT.

C. Description of monument for corner and accessories established to perpetuate locating the position of the corner:  
SET STANDARD BARRY COUNTY REMONUMENTATION MONUMENT (3/4" X 36" IRON) WITH ALUMINUM CAP.  
SET 20d NAIL W/PLASTIC TAG IN THE NORTH SIDE OF A 20" WALNUT S38°E 39.63'  
SET 20d NAIL W/PLASTIC TAG IN THE WEST SIDE OF A 22" WALNUT S20°E 66.48'  
SET 20d NAIL W/PLASTIC TAG IN THE SOUTH SIDE OF AN 11 WALNUT N89°E 48.85'  
SET 20d NAIL W/PLASTIC TAG IN THE SOUTH SIDE OF AN 8" MAPLE N40°W 36.00'  
IN LINE WITH FENCE EAST AND IN LINE WITH TREE LINE WEST  
3'+/- WEST OF NORTH-SOUTH GRAVEL ROAD

**ACT 345 BARRY COUNTY REMONUMENTATION  
APPROVED BY PEER REVIEW AT A MEETING HELD ON**

9 Feb. '98 BR  
**BRIAN REYNOLDS COUNTY SURVEYOR**

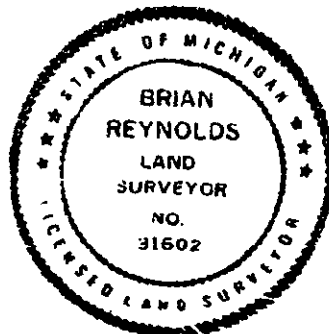

Signed by [Signature]  
Surveyor's Michigan License No. 31602

Date MAY 18, 1999  
FORM APPROVED BY MICHIGAN STATE BOARD OF LAND SURVEYORS. JAN  
REVISED MAY 14, 1975 REVISED JANUARY, 1983 REVISED OCTOBER