

SURVEY & REMONUMENTATION

FEB 17 1998

Barry County Remonumentation

SECTION

LAND CORNER RECORDATION CERTIFICATE
Filing Requirement of Act 74, Mich. P.A. 1970

For corners in Barry

(County)	Located In:	Corner Code #
1. Public Land Survey	T <u>3N</u> R <u>8W</u>	J-5 (N 1/4 14)
	T _____ R _____	Hastings Twp.
	T _____ R _____	
	T _____ R _____	
2. Property Controlling in Section	S _____ T _____ R _____	
	S _____ T _____ R _____	
3. Miscellaneous Property in Sec.	S _____ T _____ R _____	
	S _____ T _____ R _____	



2621
 Page: 1 of 1
 10/20/1997 01:01P

Sandy Schondelmayer - Barry Co. LCRCR


Register of Deeds Stamp & File Number

4. Lot No. _____, Recorded Plat _____
 5. Private Claims _____

Steven Koerber August 31 1996

I, _____, in a field survey on _____, 19 _____, do hereby certify that under requirements of P.A. 74, Michigan P.A. of 1970, the corner points mentioned in lines 1 and 2 above were in conformance with regulations and rules therefore as required in the current manual of survey instructions of the United States Department of the Interior, Bureau of Land Management or by a decree of a Court of Law and/or that the corner points mentioned in lines 3, 4 and 5 above were in conformance with the rules of the Michigan Board of Land Surveyors or by a Decree of a Court of Law; established, re-established, monumented, re-monumented, recovered, found as expressed below:

NOTE: Not more than 4 corners, all in the same town and range, may be recorded on this certificate.

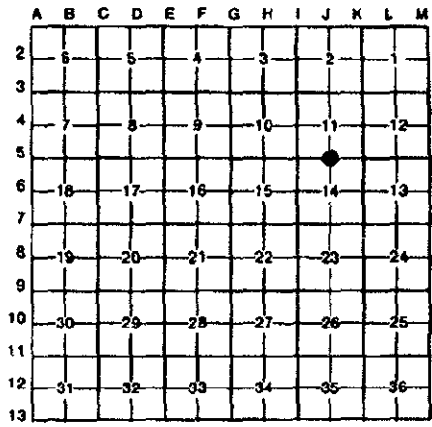

A. Description of original monument and accessories and/or subsequent restoration:

- J-5 GLO - Sylvester Sibley D.S. 1830
 A. W. Ash 7 S49E 22
 A. Sugar 5 N28W 24
- 1. Pratt 1884
 Found old stake and bricks
 SW corner Church wall N41 1/2E 90 1/2

B. Description of corner evidence found and/or method applied in restoring or reestablishing corner:

J-5 Searched for the bricks and found no monument representing the corner. Reestablished the corner by using the existing Church foundation as stated in No. 1 above. Reestablished the corner using the recorded bearing and distance from the existing corner of the old Church foundation.
 And is accepted as a careful and faithful reestablishment of the position of the original corner.

ACT 345 BARRY COUNTY REMONUMENTATION
 APPROVED BY PEER REVIEW AT A MEETING HELD ON
JULY 8, 1996
 BRIAN REYNOLDS COUNTY SURVEYOR

C. Description of monument for corner and accessories established to perpetuate locating the position of the corner:

- J-5 Set Standard Barry Co. Mon. (3/4" x 24" Iron Rod with Aluminum cap) in mon. box.
- Set spike & Barry Co. Remon. tag in E side 30" Maple N20E 84.12'
- Set spike & Barry Co. Remon. tag in NW side P. Pole N40°E 40.00'
- Set spike & Barry Co. Remon. tag in NE side 8" twin Elm N35°W 42.38'
- Set spike & Barry Co. Remon tag in NE side 30" Basswood S35E 42.04'
- C/L State Road North 1'
- C/L Fisher Road to North East 0'



Signed by [Signature] Date 10-13-1997
 Surveyor's Michigan License No. 39085